

**SURVEY &  
REMONUMENTATION**

MAR 21 1997

**COMMISSION**

CALHOUN COUNTY REMONUMENTATION

**LAND CORNER RECORDATION CERTIFICATE  
Filing Requirement of Act 74, Mich. P.A. 1970**

STATE OF MICHIGAN  
CALHOUN COUNTY  
RECORDED

7 JUN 96 9:50 A.M.

ANNE B. NORLANDER  
CLERK - REGISTER OF DEEDS

Register of Deeds Stamp & File Number

**APPROVED**  
Date May 15, 1996  
**CALHOUN COUNTY  
REMONUMENTATION.**

For corners in

<u>Calhoun</u> <small>(County)</small>	Located In:	Corner Code #
Emmett Township		
1. Public Land Survey	T <u>2</u> S R <u>7</u> W	<u>G-5</u>
	T _____ R _____	_____
	T _____ R _____	_____
	T _____ R _____	_____
2. Property Controlling in Section	S _____ T _____ R _____	_____
	S _____ T _____ R _____	_____
3. Miscellaneous Property in Sec.	S _____ T _____ R _____	_____
	S _____ T _____ R _____	_____
4. Lot No. _____, Recorded Plat _____		
5. Private Claims _____		

I, William K. Crane, in a field survey on May 11, 19 96, do hereby certify that under requirements of P.A. 74, Michigan P.A. of 1970, the corner points mentioned in lines 1 and 2 above were in conformance with regulations and rules therefore as required in the current manual of survey instructions of the United States Department of the Interior, Bureau of Land Management or by a decree of a Court of Law and/or that the corner points mentioned in lines 3, 4 and 5 above were in conformance with the rules of the Michigan Board of Land Surveyors or by a Decree of a Court of Law; established, re-established, monumented, re-monumented, recovered, found as expressed below:

**NOTE: Not more than 4 corners, all in the same town and range, may be recorded on this certificate.**

**A. Description of original monument and accessories and/or subsequent restoration:**

Original government field notes (S. Sibley 1826):

14" W. Oak      N42°W      474 links  
12" D.O.        S85°E      347 links

Resurvey F. Hodgman (1889):

Found stake standing in ditches and both government bearing trees. Set post, took no new witnesses.

Gove, 1978:

Tile  
8" Cherry      S50°W      47.25'  
Elm            S55°E      27.74'  
6" Cherry      N15°W      8.94'  
12" Cherry     N85°E      37.88'

**B. Description of corner evidence found and/or method applied in restoring or reestablishing corner:**

Found tile at SW corner of Section 10 and SW corner of the plat of Eastland. One witness from Gove (1978) remained:

6" Cherry            N15°W            8.94'


LIBER 1865 PAGE 709

**C. Description of monument for corner and accessories established to perpetuate locating the position of the corner:**

Replaced tile with standard Calhoun County Remonumentation Monument (Bernsten Monument).

Found nail-6" Cherry      N20°W      8.94'  
Found nail-6" Cherry      N45°W      13.76'  
Found nail-4" Cherry      N05°W      6.29'  
Set nail & Remon. Tag  
in 6" Cherry                S25°W      14.36'

This is accepted as a careful and faithful perpetuation of the position of the original corner.

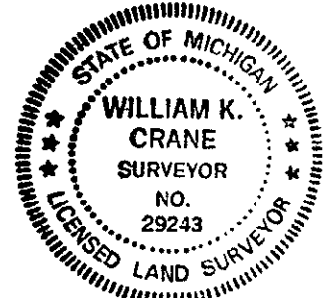

Signed by William K. Crane Date May 14, 1996  
Surveyor's Michigan License No. 29243