

APPROVED

Date 12/10/99 REC  
CALHOUN COUNTY  
REMONUMENTATION.

CALHOUN COUNTY REMONUMENTATION  
LAND CORNER RECORDATION CERTIFICATE  
Filing Requirement of Act 74, Mich. P.A. 1970

STATE OF MICHIGAN  
CALHOUN COUNTY  
RECORDED

For corners in

|                                    |                         |               |
|------------------------------------|-------------------------|---------------|
| <u>CALHOUN</u>                     | Located In:             | Corner Code # |
| (County)                           |                         |               |
| EMMETT TOWNSHIP                    |                         |               |
| 1. Public Land Survey              | T <u>2S</u> R <u>7W</u> | <u>G-6</u>    |
|                                    | T _____ R _____         | _____         |
|                                    | T _____ R _____         | _____         |
|                                    | T _____ R _____         | _____         |
| 2. Property Controlling in Section | S _____ T _____ R _____ | _____         |
|                                    | S _____ T _____ R _____ | _____         |
| 3. Miscellaneous Property in Sec.  | S _____ T _____ R _____ | _____         |
|                                    | S _____ T _____ R _____ | _____         |

17 DEC 1999 2:34:13 PM

ANNE B. NORLANDER  
CLERK - REGISTER OF DEEDS

LIBER **2185** PAGE **992**

Register of Deeds Stamp & File Number

4. Lot No. \_\_\_\_\_, Recorded Plat \_\_\_\_\_  
5. Private Claims \_\_\_\_\_

I, Michael A. Groat, in a field survey on December 6, 1999 do hereby state that under requirements of P.A. 74, Michigan P.A. of 1970, the corner points mentioned in lines 1 and 2 above were in conformance with regulations and rules therefore as required in the current manual of survey instructions of the United States Department of the Interior, Bureau of Land Management or by a decree of a Court of Law and for that the corner points mentioned in lines 3, 4 and 5 above were in conformance with the rules of the Michigan Board of Land Surveyors or by a Decree of a Court of Law; established, re-established, monumented, recovered, found as expressed below:

NOTE: Not more than 2 corners, all in the same town and range, may be recorded on this certificate.

|    |    |    |    |    |    |    |   |   |   |   |   |   |   |
|----|----|----|----|----|----|----|---|---|---|---|---|---|---|
|    | A  | B  | C  | D  | E  | F  | G | H | I | J | K | L | M |
| 1  |    |    |    |    |    |    |   |   |   |   |   |   |   |
| 2  | 6  | 5  | 4  | 3  | 2  | 1  |   |   |   |   |   |   |   |
| 3  |    |    |    |    |    |    |   |   |   |   |   |   |   |
| 4  | 7  | 8  | 9  | 10 | 11 | 12 |   |   |   |   |   |   |   |
| 5  |    |    |    |    |    |    |   |   |   |   |   |   |   |
| 6  | 18 | 17 | 16 | 15 | 14 | 13 |   |   |   |   |   |   |   |
| 7  |    |    |    |    |    |    |   |   |   |   |   |   |   |
| 8  | 19 | 20 | 21 | 22 | 23 | 24 |   |   |   |   |   |   |   |
| 9  |    |    |    |    |    |    |   |   |   |   |   |   |   |
| 10 | 30 | 29 | 28 | 27 | 26 | 25 |   |   |   |   |   |   |   |
| 11 |    |    |    |    |    |    |   |   |   |   |   |   |   |
| 12 | 31 | 32 | 33 | 34 | 35 | 36 |   |   |   |   |   |   |   |
| 13 |    |    |    |    |    |    |   |   |   |   |   |   |   |

A. Description of original monument and accessories and/or subsequent restoration:

ORIGINAL SURVEY, 1826, SYLVESTER SIBLEY, SET POST, B. OAK 9", S 67° W, 107 LINKS, ELM 11", N 87° E, 83 LINKS.

RE-SURVEY, 1889 BY F. HODGEMAN, FOUND STAKE, BURR OAK, 4", S 40° E, 75 LINKS, HICKORY 6", N 85 1/2° W, 1.58 LINKS.


C. PIKE, P.S., 8/73, 2" PIPE, CHERRY, S 05° W, 3.85', WALNUT, NORTH, 40.57' OAK, N 75° W, 15.2', IN LINE WITH TREE ROW WEST. R.R. CARR, 2/95, FOUND 2" PIPE, 3' OUT OF GROUND, 48" OAK, N 69° E, 60.71'; 12" CHERRY, S 05° W, 3.85' 20" OAK, N 65° W, 15.20'; 12" ASH, S 39° W, 59.02'

B. Description of corner evidence found and/or method applied in restoring or reestablishing corner:

FOUND 2" PIPE 3' OUT OF GROUND AS CALLED FOR ABOVE. EXCAVATED BUT FOUND NOTHING ELSE. OLD NOTES CALL FOR CORNER TO BE IN A "DITCH". THIS PIPE WAS ON THE EDGE OF A SWAMP WITH NO "DITCH" IN SIGHT. THIS SWAMP TODAY COULD HAVE BEEN A DITCH 100 YEARS AGO. THE HOLE FILLS WITH WATER AT A DEPTH OF 1 FOOT. ACCEPTED THE PIPE AS THE BEST EVIDENCE OF THE LOCATION OF THE ORIGINAL CORNER.

C. Description of monument for corner and accessories established to perpetuate locating the position of the corner:

SET BERNTSEN MONUMENT IN PLACE OF PIPE.  
NAIL & SPOTTER IN 48" OAK, N 69° E, 60.71' (CARR)  
NAIL & SPOTTER IN 12" CHERRY, S 05° W, 3.85' (CARR)  
NAIL & SPOTTER IN 20" OAK, N 65° W, 15.20' (CARR)  
NAIL & SPOTTER IN 12" ASH, S 39° W, 59.02' (CARR)  
CARSONITE MARKER ON EAST SIDE  
REPLACED PIPE ON NORTH SIDE

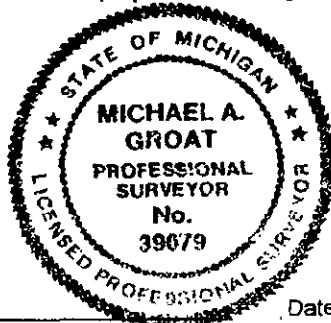

Signed by Michael A. Groat  
Surveyor's Michigan License No. 39079

Date December 7, 1999

SURVEY &  
REMONUMENTATION

MAR 13 2000

SECTION