

APPROVED

Date 11-12-96

CALHOUN COUNTY REMONUMENTATION.

CALHOUN COUNTY REMONUMENTATION LAND CORNER RECORDATION CERTIFICATE Filing Requirement of Act 74, Mich. P.A. 1970

STATE OF MICHIGAN CALHOUN COUNTY RECORDED

19 FEB 97 3:50 P.M.

ANNE B. NORLANDER CLERK - REGISTER OF DEEDS

LIBER 1916 PAGE 112

Register of Deeds Stamp & File Number

Form with fields for Calhoun (County), Located In, Corner Code, and numbered items 1-5 for survey details.

Grid table with columns A-M and rows 2-13, containing section numbers 1-36.

Emmett Township

I, Robert R. Carr, in a field survey on October 22, 1996, do hereby certify that under requirements of P.A. 74, Michigan P.A. of 1970, the corner points mentioned in lines 1 and 2 above were in conformance with regulations and rules therefore as required in the current manual of survey instructions of the United States Department of the Interior, Bureau of Land Management or by a decree of a Court of Law and/or that the corner points mentioned in lines 3, 4 and 5 above were in conformance with the rules of the Michigan Board of Land Surveyors or by a Decree of a Court of Law; established, re-established, monumented, re-monumented, recovered, found as expressed below:

NOTE: Not more than 4 corners, all in the same town and range, may be recorded on this certificate.


A. Description of original monument and accessories and/or subsequent restoration: Corner not set by G.L.O.

SURVEY & REMONUMENTATION

APR 07 1998

SECTION

B. Description of corner evidence found and/or method applied in restoring or reestablishing corner: Found 1" x 2' long iron pipe in bed of stones 7.26 feet West of tile at S 1/4 post of Section 34, T1S, R7W. 7.26 feet is average of G.L.O. jogs at NE & NW corners of Section 3. Accepted iron pipe in stones as corner.

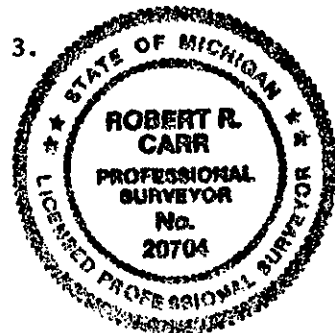

C. Description of monument for corner and accessories established to perpetuate locating the position of the corner: Replaced iron pipe with Berntsen Calhoun County Remonumentation Monument with Carsonite witness post beside.

- Nail & spotter Easterly side 14" Oak N10°W 35.61 feet.
Nail & spotter Northeasterly side 14" Oak N57°W 17.09 feet.
Nail & spotter Northwesterly side 24" Oak S64°W 26.03 feet.
Nail & spotter Southwesterly side 8" cherry S40°E 26.53 feet.
0.72 feet West of RR tie corner post
Nail & spotter Northwesterly side 14" Hickory S40°W, 36.95 feet fences E/W and S (fence to W fallen).

Signed by Robert R. Carr Date February 14, 1997 Surveyor's Michigan License No. 20704