

APPROVED
 Date 11-12-96
CALHOUN COUNTY
REMONUMENTATION
 For corners in

CALHOUN COUNTY REMONUMENTATION
LAND CORNER RECORDATION CERTIFICATE
 Filing Requirement of Act 74, Mich. P.A. 1970

STATE OF MICHIGAN
 CALHOUN COUNTY
 RECORDED
 19 NOV 96 1:52 P.M.

ANNE B. NORLANDER
 CLERK - REGISTER OF DEEDS

LIBER **1899** PAGE **599**

Register of Deeds Stamp & File Number

<u>Calhoun</u> (County) <u>Emmett Twp</u>	Located In:	Corner Code #
1. Public Land Survey Sec 3	T <u>2</u> S R <u>7</u> W	<u>H-3</u>
	T _____ R _____	_____
	T _____ R _____	_____
	T _____ R _____	_____
2. Property Controlling in Section	S _____ T _____ R _____	_____
	S _____ T _____ R _____	_____
3. Miscellaneous Property in Sec.	S _____ T _____ R _____	_____
	S _____ T _____ R _____	_____
4. Lot No. _____, Recorded Plat _____		
5. Private Claims _____		

A	B	C	D	E	F	G	H	I	J	K	L	M
2	6	5	4	3	2	1						
3				●								
4	7	8	9	10	11	12						
5												
6	18	17	16	15	14	13						
7												
8	19	20	21	22	23	24						
9												
10	30	29	28	27	26	25						
11												
12	31	32	33	34	35	36						
13												

Emmett Township

SURVEY & REMONUMENTATION

MAR 21 1997

COMMISSION

I, Robert R. Carr, in a field survey on November 9, 19 96, do hereby certify that under requirements of P.A. 74, Michigan P.A. of 1970, the corner points mentioned in lines 1 and 2 above were in conformance with regulations and rules therefore as required in the current manual of survey instructions of the United States Department of the Interior, Bureau of Land Management or by a decree of a Court of Law and/or that the corner points mentioned in lines 3, 4 and 5 above were in conformance with the rules of the Michigan Board of Land Surveyors or by a Decree of a Court of Law; established, re-established, monumented, re-monumented, recovered, found as expressed below:

NOTE: Not more than 4 corners, all in the same town and range, may be recorded on this certificate.

A. Description of original monument and accessories and/or subsequent restoration:


- G.L.O.; S. Sibley 1826
- Resurvey; Hodgeman 1889 found stake with brick around and set post
- H.K.W. 1927 found 3" solid tile took new witness.
- A.H. Chase 1950 spike in blocktop.

B. Description of corner evidence found and/or method applied in restoring or reestablishing corner:

- Found boat spike over 3"x2' solid tile.
- Hodgeman 3" Burr Oak N78-1/2°E, 39-1/4 ^{LKS, R22} feet still stands now 30" Burr Oak N82-1/2°E 25.68 feet
- Accepted tile as true perpetuation of original corner.

C. Description of monument for corner and accessories established to perpetuate locating the position of the corner:

- Replaced tile with Berntsen Calhoun County Remonumentation Monument in monument box.
- Nail & spotter Easterly side of 24" White Oak N29°E 59.98 feet.
- NW corner house foundation S74°E 72.10 feet
- NE corner house #535 foundation S79°W 97.36 feet.
- Nail & spotter Easterly side U-Pole N07°W 136.33 feet.
- 1'± West of centerline N/S road.

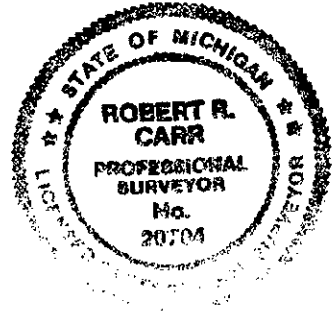

Signed by Robert R. Carr Date November 11, 1996
 Surveyor's Michigan License No. 20704