

APPROVED

Date 11-12-96

CALHOUN COUNTY REMONUMENTATION

CALHOUN COUNTY REMONUMENTATION LAND CORNER RECORDATION CERTIFICATE Filing Requirement of Act 74, Mich. P.A. 1970

STATE OF MICHIGAN CALHOUN COUNTY RECORDED

For corners in

Calhoun

(County)

Emmett Twp

Located In:

Corner Code #

19 NOV 96 1:52 P.M.

ANNE B. NORLANDER CLERK - REGISTER OF DEEDS

LIBER 1899 PAGE 597

Register of Deeds Stamp & File Number

Table with 4 columns: Description, Section, Township/Range, Corner Code. Includes entries for Public Land Survey, Property Controlling in Section, and Miscellaneous Property in Sec.

- 4. Lot No. Recorded Plat
5. Private Claims

I, Robert R. Carr, in a field survey on October 24, 1996, do hereby certify that under requirements of P.A. 74, Michigan P.A. of 1970, the corner points mentioned in lines 1 and 2 above were in conformance with regulations and rules therefore as required in the current manual of survey instructions of the United States Department of the Interior, Bureau of Land Management or by a decree of a Court of Law and/or that the corner points mentioned in lines 3, 4 and 5 above were in conformance with the rules of the Michigan Board of Land Surveyors or by a Decree of a Court of Law; established, re-established, monumented, re-monumented, recovered, found as expressed below:

NOTE: Not more than 4 corners, all in the same town and range, may be recorded on this certificate.

A. Description of original monument and accessories and/or subsequent restoration:

- 1. G.L.O.; Sibley 1826
2. Resurvey; Hodgeman, 1889, found stake with 16"x12"x4" stone beside. and set tile in place of stake beside stone.
3. LCRC by Robert R. Carr, 1990 Liber 1556 page 133.

B. Description of corner evidence found and/or method applied in restoring or reestablishing corner:

Found RR spike over iron pipe over solid tile with 16"x12"x4" stone on Westerly side matching witnesses to LCRC by Carr. Accepted tile as a true perpetuation of original corner.


C. Description of monument for corner and accessories established to perpetuate locating the position of the corner:

Replaced tile with Berntsen Calhoun County Remonumentation Monument in monument box. Consumer Power Co. marker N87°W 20.60' to center at ground. Nail & spotter Southerly side U-Pole N68°E 85.18 feet. Nail & spotter Easterly side 30" Oak N27°E 83.65 feet. Nail & spotter Westerly side 24" Oak S22°W 79.16 feet.

SURVEY & REMONUMENTATION

MAR 21 1997

COMMISSION

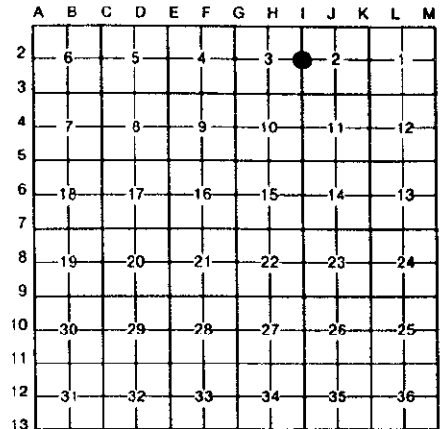

Emmett Township

Signed by [Signature] Robert R. Carr Surveyor's Michigan License No. 20704

Date November 8, 1996

