

APPROVED
 Date 11-12-96
CALHOUN COUNTY
REMONUMENTATION

CALHOUN COUNTY REMONUMENTATION
LAND CORNER RECORDATION CERTIFICATE
 Filing Requirement of Act 74, Mich. P.A. 1970

STATE OF MICHIGAN
 CALHOUN COUNTY
 RECORDED

19 NOV 96 1:52 P.M.

ANNE B. NORLANDER
 CLERK - REGISTER OF DEEDS


LIBER **1899** PAGE **598**

Register of Deeds Stamp & File Number

Robert R. Carr Located In: Corner Code #
 (County) Emmett Twp

1. Public Land Survey	Sec 3	T 2 S R 7 W	I-3
		T ___ R ___	_____
		T ___ R ___	_____
		T ___ R ___	_____
2. Property Controlling in Section	S ___ T ___ R ___	_____	_____
	S ___ T ___ R ___	_____	_____
3. Miscellaneous Property in Sec.	S ___ T ___ R ___	_____	_____
	S ___ T ___ R ___	_____	_____

4. Lot No. _____, Recorded Plat _____
 5. Private Claims _____

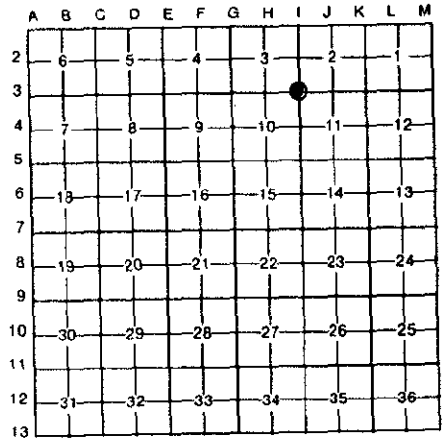

Emmett Township

I, Robert R. Carr, in a field survey on November 8, 19 96, do hereby certify that under requirements of P.A. 74, Michigan P.A. of 1970, the corner points mentioned in lines 1 and 2 above were in conformance with regulations and rules therefore as required in the current manual of survey instructions of the United States Department of the Interior, Bureau of Land Management or by a decree of a Court of Law and/or that the corner points mentioned in lines 3, 4 and 5 above were in conformance with the rules of the Michigan Board of Land Surveyors or by a Decree of a Court of Law; established, re-established, monumented, re-monumented, recovered, found as expressed below:

NOTE: Not more than 4 corners, all in the same town and range, may be recorded on this certificate.

A. Description of original monument and accessories and/or subsequent restoration:

G.L.O. S. Sibley D.S. 1826
 Resurvey; Hodgeman 1889, found a stone said by Mr. Katner to have been planted by him 36 years earlier at place of original post, set post (tile).
 Gove, 1978, 3/4" iron over tile.

B. Description of corner evidence found and/or method applied in restoring or reestablishing corner:

Found 3/4" iron pipe over 3/4 solid iron over 3"x2' solid tile.
 Accepted tile as true perpetuation of corner.


SURVEY & REMONUMENTATION

MAR 21 1997

COMMISSION

C. Description of monument for corner and accessories established to perpetuate locating the position of the corner:

Replaced tile with Berntsen Calhoun County Remonumentation Monument in monument box.
 Nail & spotter in Westerly side 26" Oak S23°E 56.19 feet.
 Nail & spotter in Southerly side 13" Oak N73°E 48.81 feet.
 Nail & spotter in Easterly side 18" Oak N05°W 45.32 feet.
 SW corner house # 16993 S57°W 148.60 feet.
 Nail & spotter in Northeasterly side 48" Oak N51°W 16.09 feet.
 Nail & spotter in Northerly ^AU-Pole N74°W 25.29 feet.

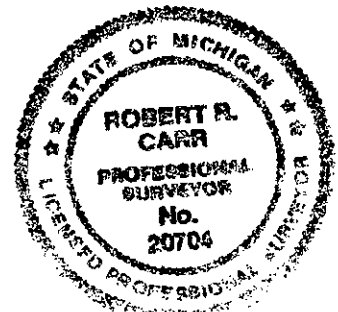

Signed by Robert R. Carr
 Surveyor's Michigan License No. 20704

Date November 11, 1996