

SURVEY & REMONUMENTATION

MAR 21 1997

COMMISSION

APPROVED
Date May 15, 1996
**CALHOUN COUNTY
REMONUMENTATION.**

CALHOUN COUNTY REMONUMENTATION

LAND CORNER RECORDATION CERTIFICATE Filing Requirement of Act 74, Mich. P.A. 1970

STATE OF MICHIGAN
CALHOUN COUNTY
RECORDED

7 JUN 96 9:49 A.M.

ANNE B. NORLANDER
CLERK - REGISTER OF DEEDS

For corners in


<u>Calhoun</u> <small>(County)</small>	Located In:	Corner Code #	
<u>Emmett Township</u>			
1. Public Land Survey	T <u>2 S</u> R <u>7 W</u>	<u>I-4</u>	
	T _____ R _____	_____	
	T _____ R _____	_____	
	T _____ R _____	_____	
2. Property Controlling in Section	S _____ T _____ R _____	_____	
	S _____ T _____ R _____	_____	
3. Miscellaneous Property in Sec.	S _____ T _____ R _____	_____	
	S _____ T _____ R _____	_____	

Register of Deeds Stamp & File Number

4. Lot No. _____, Recorded Plat _____
5. Private Claims _____

I, William K. Crane, in a field survey on May 11, 19 96, do hereby certify that under requirements of P.A. 74, Michigan P.A. of 1970, the corner points mentioned in lines 1 and 2 above were in conformance with regulations and rules therefore as required in the current manual of survey instructions of the United States Department of the Interior, Bureau of Land Management or by a decree of a Court of Law and/or that the corner points mentioned in lines 3, 4 and 5 above were in conformance with the rules of the Michigan Board of Land Surveyors or by a Decree of a Court of Law; established, re-established, monumented, re-monumented, recovered, found as expressed below:

NOTE: Not more than 4 corners, all in the same town and range, may be recorded on this certificate.

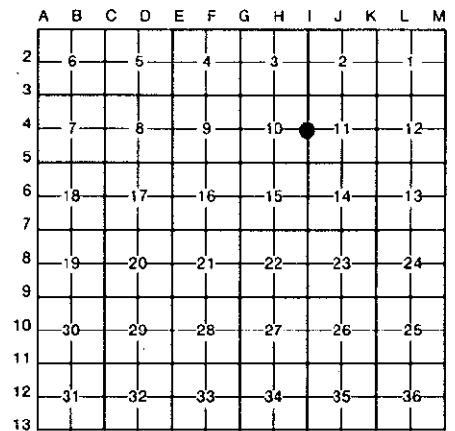

A. Description of original monument and accessories and/or subsequent restoration:

Original government field notes (S. Sibley 1826):

8" Burr Oak N48°W 33 links
10" B. Oak S37°E 62 links

Resurvey F. Hodgman, 1889:

Set post midway and on line between Section Corners.

18" Burr Oak N55°E 113 links

LCRC recorded 1/8/74 by James King in L. 1032, P. 594 (same witnesses as L.W. Chase 1962 and P.E. Rosendale 1960):

1/2" iron flush with top of bit. pavement
1.4' West of centerline of road
NW Cor. Hse. Fndn. S.E. 89.55'
SE Cor. Gar. Fndn. N.W. 110.27'
6" Maple N83°E 29.98'
12" Maple S28°E 55.97'
12" Oak S80°W 20.29'

B. Description of corner evidence found and/or method applied in restoring or reestablishing corner:

Found 1/2" iron over 3/4" pipe with stones and pieces of broken tile.
One witness tree remains.

12" Maple S28°E 55.97'
(now 34")

LIBER 1865 PAGE 708

C. Description of monument for corner and accessories established to perpetuate locating the position of the corner:

Replace 1/2" iron with Standard Calhoun County Remonumentation Monument (Bernsten Monument) and Monument Box.

Concrete Monuement	West	33.01'
(for plat of Hidden Forest)		
Set nail & spotter	S45°W	44.40'
(N. side 12" Oak)		
Set nail & spotter	S28°E	55.67'
(W. side 34" Maple)		
Power Pole	N20°E	44.67'

This is accepted as the best available evidence of the position of the original corner.

Signed by William K. Crane
William K. Crane

Date May 14, 1996

Surveyor's Michigan License No. 29243

