

APPROVED

Date 2-2-94
CALHOUN COUNTY
REMONUMENTATION.

CALHOUN COUNTY REMONUMENTATION
LAND CORNER RECORDATION CERTIFICATE
Filing Requirement of Act 74, Mich. P.A. 1970

For corners in

Calhoun
(County)

Located In:
Emmett Twp.

Corner Code ##

- 1. Public Land Survey T 2S R 7W I-5
T _____ R _____
T _____ R _____
T _____ R _____
- 2. Property Controlling S _____ T _____ R _____
in Section S _____ T _____ R _____
- 3. Miscellaneous S _____ T _____ R _____
Property in Sec. S _____ T _____ R _____

- 4. Lot No. _____, Recorded Plat _____
- 5. Private Claims _____

FEB 4 3 12 PM 94
CLERK-REGISTER
CALHOUN COUNTY, MICH
ANN F. B. MORLANDER

RECORDED

Register of Deeds Stamp & File Number

I, Daniel M. Ryan, in a field survey on November 7, 19 93, do hereby certify that under requirements of P.A. 74, Michigan P.A. of 1970, the corner points mentioned in lines 1 and 2 above were in conformance with regulations and rules therefore as required in the current manual of survey instructions of the United States Department of the Interior, Bureau of Land Management or by a decree of a Court of Law and/or that the corner points mentioned in lines 3, 4 and 5 above were in conformance with the rules of the Michigan Board of Land Surveyors or by a Decree of a Court of Law; established, re-established, monumented, re-monumented, recovered, found as expressed below:

NOTE: Not more than 4 corners, all in the same town and range, may be recorded on this certificate.

A. Description of original monument and accessories and/or subsequent restoration:

Southeast corner of Section 10
RESURVEY - 1889, Hodgeman:
Set tile in place of GLO post
Yellow Oak, 8", S10°E, 2-3/4 links
Yellow Oak, 12", S45°W, 5-3/4 links

L.W. Chase - 1962:
Found tile with cross 6" under ground
by large hickory tree.
22" Hickory, N49°E, 2.13'.
24" Cherry, S77°W, 27.52'.
Iron R/R fence post, South, 8.09'.
Cemetery 8" well, (face pipe), Southwest, 133.07'.

B. Description of corner evidence found and/or method applied in restoring or reestablishing corner:

Found tile with cross 6" under ground beside large hickory.
All witnesses shown by Chase are existing and measure good.


SURVEY &
REMONUMENTATION

OCT 27 1994

COMMISSION

C. Description of monument for corner and accessories established to perpetuate locating the position of the corner:
Set standard Calhoun County Monument (Berntsen) with Brass cap and drill hole. Stamped license number 34975 in top. Set 6' carsonite survey marker beside corner.

Witnesses:
26" Hickory, N49°E, 2.13'.
24" Cherry, S77°W, 27.52'.
Iron R.R. fence post South 8.01'.
8" Well (face of pipe) Southwest, 133.07'.

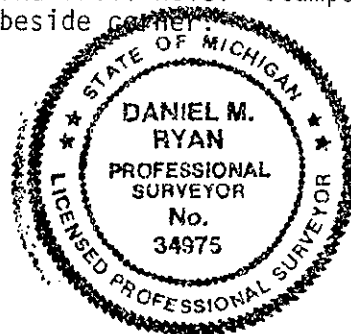

Signed by Daniel M. Ryan Date November 7, 1993

Surveyor's Michigan License No. 34975

LIBER 1730 PAGE 830