

APPROVED

Date 2-2-94 AAA

CALHOUN COUNTY
REMONUMENTATION.

CALHOUN COUNTY REMONUMENTATION
LAND CORNER RECORDATION CERTIFICATE
Filing Requirement of Act 74, Mich. P.A. 1970

CLERK-REGISTER
CALHOUN COUNTY, MICH.
ANNE B. NORLANDER

FEB 4 3 11 PM '94

RECORDED

For corners in

<u>Calhoun</u> (County)	Located In: Emmett Twp.	Corner Code # <u>J-5</u>
1. Public Land Survey	T <u>2S</u> R <u>7W</u>	<u>J-5</u>
	T _____ R _____	_____
	T _____ R _____	_____
	T _____ R _____	_____
2. Property Controlling in Section	S _____ T _____ R _____	_____
	S _____ T _____ R _____	_____
3. Miscellaneous Property in Sec.	S _____ T _____ R _____	_____
	S _____ T _____ R _____	_____

Register of Deeds Stamp & File Number

- 4. Lot No. _____, Recorded Plat _____
- 5. Private Claims _____

A	B	C	D	E	F	G	H	I	J	K	L	M
2	6	5	4	3	2	1						
3												
4	7	8	9	10	11	12						
5												
6	18	17	16	15	14	13						
7												
8	19	20	21	22	23	24						
9												
10	30	29	28	27	26	25						
11												
12	31	32	33	34	35	35						
13												

I, Daniel M. Ryan, in a field survey on November 7, 19 93, do hereby certify that under requirements of P.A. 74, Michigan P.A. of 1970, the corner points mentioned in lines 1 and 2 above were in conformance with regulations and rules therefore as required in the current manual of survey instructions of the United States Department of the Interior, Bureau of Land Management or by a decree of a Court of Law and/or that the corner points mentioned in lines 3, 4 and 5 above were in conformance with the rules of the Michigan Board of Land Surveyors or by a Decree of a Court of Law; established, re-established, monumented, re-monumented, recovered, found as expressed below:

NOTE: Not more than 4 corners, all in the same town and range, may be recorded on this certificate.

A. Description of original monument and accessories and/or subsequent restoration:
RESURVEY 1889 - Hodgeman: Witnesses - Noref available:
Lost: Reset midway & on line Fence post, N26°W, 76.7'.
between section corners. Fence post, South, 12.13'.
In line with fence North & South. 30" Stump, N66°W, 17.06'.
No tree nearby. South edge of Called for 3/4" pipe in conc.
of small pond now dry.

1928:
S.P. Forest Park.
Liber 7, page 24.
SE corner of Lot 31
Noref as to corner marking.


B. Description of corner evidence found and/or method applied in restoring or reestablishing corner:
Found clay tile and 3/4" iron pipe with flagging.
In line with fence North and South and marking the Southeast corner of Lot 31 of SUPERVISOR'S PLAT OF FOREST PARK.
The section line measures as shown below:

SURVEY &
REMONUMENTATION

OCT 27 1994

COMMISSION

C. Description of monument for corner and accessories established to perpetuate locating the position of the corner:
Removed tile and 3/4" iron pipe. Set standard Calhoun County monument (Berntsen) with brass cap and drill hole. Stamped license number 34975 in top.
In line with North and South fence.
18" Pine, West, 18.32'. Spotter on North side.
12" Cherry, N85°E, 6.20'. Spotter on South side.
12" Cherry, S85°E, 7.95'. Spotter on North side.
12" Ash, N10°E, 17.90'. Spotter on East side.

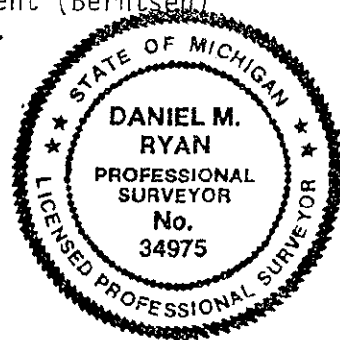

LIBER 1730 PAGE 828

Signed by Daniel M. Ryan Date November 7, 1993
Surveyor's Michigan License No. 34975