

APPROVED

Date 2-2-94
CALHOUN COUNTY
REMONUMENTATION.

CALHOUN COUNTY REMOUNTATION
LAND CORNER RECORDATION CERTIFICATE
Filing Requirement of Act 74, Mich. P.A. 1970

For corners in

Calhoun
(County)

Located In:

Corner Code #

- 1. Public Land Survey T 2S R 7W K-6
- T _____ R _____
- T _____ R _____
- T _____ R _____
- 2. Property Controlling S _____ T _____ R _____
- in Section S _____ T _____ R _____
- 3. Miscellaneous S _____ T _____ R _____
- Property in Sec. S _____ T _____ R _____
- 4. Lot No. _____, Recorded Plat _____
- 5. Private Claims _____

CLERK-REGISTER
CALHOUN COUNTY, MICH.
ANNIE B. NORLANDER

FEB 4 3 12 PM '94

RECORDED

Register of Deeds Stamp & File Number

	A	B	C	D	E	F	G	H	I	J	K	L	M
2	6	5	4	3	2	1							
3													
4	7	8	9	10	11	12							
5													
6	18	17	16	15	14	13							
7													
8	19	20	21	22	23	24							
9													
10	30	29	28	27	26	25							
11													
12	31	32	33	34	35	36							
13													

I, Michael A. Groat, in a field survey on January 12, 1994, do hereby certify that under requirements of P.A. 74, Michigan P.A. of 1970, the corner points mentioned in lines 1 and 2 above were in conformance with regulations and rules therefore as required in the current manual of survey instructions of the United States Department of the Interior, Bureau of Land Management or by a decree of a Court of Law and/or that the corner points mentioned in lines 3, 4 and 5 above were in conformance with the rules of the Michigan Board of Land Surveyors or by a Decree of a Court of Law; established, re-established, monumented, re-monumented, recovered, found as expressed below:

NOTE: Not more than 4 corners, all in the same town and range, may be recorded on this certificate.

A. Description of original monument and accessories and/or subsequent restoration:

Hodgeman 1889 Re-Survey
Found stake S74°W 59 lks from stump of Burr Oak bearing tree of R.B. Merrit.
Set post:
Burr Oak, 12" N31°E 109 lks
Hickory, 12" S20°E, 116 lks

Clifford Smith-No date
Placed mon box over clay tile with 1/2" rod over Sign post, N50°E, 63.72'
32" Oak, S72°W, 27.72'
P.P., S28°E, 65.36'

Gove 1978
1-1/2" Iron
30" Oak S72°W, 27.67'
U.P., S35°E, 65.25'
U.P., N40°E, 50.95'

B. Description of corner evidence found and/or method applied in restoring or reestablishing corner:

Found 1/2" Iron Rod in monument box, pieces of broken tile below.
No witnesses remaining.

SURVEY &
REMONUMENTATION

OCT 27 1994

COMMISSION


LIBER 1730 PAGE 832

C. Description of monument for corner and accessories established to perpetuate locating the position of the corner:

Set standard Calhoun County Monument (Berntsen) with brass cap and drill hole. Stamped license #39079 and corner information in top.

Witnesses:

- Nail with spotter in U.P., N40°E, 52.4'
- Nail with spotter in U.P., S50°E, 67.4'
- NE corner of Gas Station, N50°W, 90.7'
- SE corner of Gas Station, S75°W, 66.6'

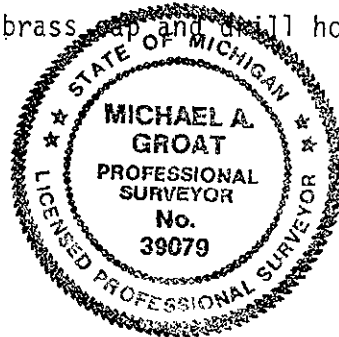

Signed by Michael A. Groat

Date 2-2-94

Surveyor's Michigan License No. 39079