

APPROVED

Date Dec 6 1995

CALHOUN COUNTY REMONUMENTATION.

CALHOUN COUNTY REMONUMENTATION LAND CORNER RECORDATION CERTIFICATE Filing Requirement of Act 74, Mich. P.A. 1970

STATE OF MICHIGAN CALHOUN COUNTY RECORDED

12 DEC 95 11:00 A.M.

For corners in

Table with columns: Calhoun (County), Emmett Township, Located In, Corner Code. Includes entries for Public Land Survey, Property Controlling in Section, and Miscellaneous Property in Sec.

ANNE B. NORLANDER CLERK - REGISTER OF DEEDS

LIBER 1835 PAGE 421

Register of Deeds Stamp & File Number

4. Lot No. \_\_\_\_\_, Recorded Plat \_\_\_\_\_
5. Private Claims \_\_\_\_\_

Grid table with columns A-M and rows 2-13. A black dot is present in row 9, column J.

I, William K. Crane, in a field survey on November 22, 1995, do hereby certify that under requirements of P.A. 74, Michigan P.A. of 1970, the corner points mentioned in lines 1 and 2 above were in conformance with regulations and rules therefore as required in the current manual of survey instructions of the United States Department of the Interior, Bureau of Land Management or by a decree of a Court of Law and/or that the corner points mentioned in lines 3, 4 and 5 above were in conformance with the rules of the Michigan Board of Land Surveyors or by a Decree of a Court of Law; established, re-established, monumented, re-monumented, recovered, found as expressed below:


NOTE: Not more than 4 corners, all in the same town and range, may be recorded on this certificate.

A. Description of original monument and accessories and/or subsequent restoration:

Original government field notes (S. Sibley 1826) 8" W.Oak S66°E 30 links 10" D.O. N82°W 40 links
Resurvey F. Hodgman 1889 Reset corner from the stump of one original bearing tree. 14" Y.Oak S25°W 80 links 6" Hickory N22°E 114 links
Records of Dekeyser & Assoc. 1978 Iron 10" below surface 30" B.O. N75°W 31.0' 1' West of centerline N&S Road 536.7" North of North end of bridge 28" Cherry N40°E 40.41' 20" Hickory S45°E 41.13'

B. Description of corner evidence found and/or method applied in restoring or reestablishing corner: Found 1" pipe 1.5' West of centerline of 11 Mile Road as used in several previous surveys.

REMONUMENTATION FEB 22 1996 COMMISSION

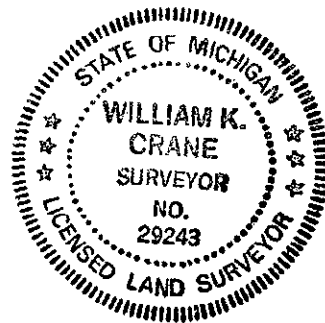

C. Description of monument for corner and accessories established to perpetuate locating the position of the corner:

Replaced pipe with Standard Calhoun County Remonumentation Monument (Bernsten Monument) and a monument box.

36" Cherry N20°E 41.00'
10" Elm N20°W 51.22'
8" Maple West 32.55'
8" Cherry S25°W 76.35'

This is accepted as the best available evidence of the position of the original corner.

Signed by William K. Crane

Date 12/1/95

Surveyor's Michigan License No. # 29243