

APPROVED

Date Dec 6, 1995
CALHOUN COUNTY
REMONUMENTATION.

STATE OF MICHIGAN
CALHOUN COUNTY
RECORDED

CALHOUN COUNTY REMONUMENTATION
LAND CORNER RECORDATION CERTIFICATE
Filing Requirement of Act 74, Mich. P.A. 1970

12 DEC 95 11:00 A.M.

ANNE B. NORLANDER
CLERK - REGISTER OF DEEDS

For corners in

Calhoun (County) Emmett Township	Located In:	Corner Code -#
1. Public Land Survey	T <u>2S</u> R <u>7W</u>	<u>K-10</u>
	T _____ R _____	_____
	T _____ R _____	_____
	T _____ R _____	_____
2. Property Controlling in Section	S _____ T _____ R _____	_____
	S _____ T _____ R _____	_____
3. Miscellaneous Property in Sec.	S _____ T _____ R _____	_____
	S _____ T _____ R _____	_____

LIBER 1835 PAGE 422

Register of Deeds Stamp & File Number

- 4. Lot No. _____, Recorded Plat _____
- 5. Private Claims _____

	A	B	C	D	E	F	G	H	I	J	K	L	M
2	6		5		4		3		2		1		
3													
4	7		8		9		10		11		12		
5													
6	18		17		16		15		14		13		
7													
8	19		20		21		22		23		24		
9													
10	30		29		28		27		26		25		
11													
12	31		32		33		34		35		36		
13													

I, William K. Crane in a field survey on November 13, 19 95, do hereby certify that under requirements of P.A. 74, Michigan P.A. of 1970, the corner points mentioned in lines 1 and 2 above were in conformance with regulations and rules therefore as required in the current manual of survey instructions of the United States Department of the Interior, Bureau of Land Management or by a decree of a Court of Law and/or that the corner points mentioned in lines 3, 4 and 5 above were in conformance with the rules of the Michigan Board of Land Surveyors or by a Decree of a Court of Law; established, re-established, monumented, re-monumented, recovered, found as expressed below:

NOTE: Not more than 4 corners, all in the same town and range, may be recorded on this certificate.

A. Description of original monument and accessories and/or subsequent restoration:

Original government field notes (S. Sibley 1826)	Resurvey F. Hodgman 1889
16" B.Oak N86°E 65 links	Lost set post midway between
24" D.O. S40°E 117 links	and 40.46 from section corners
	North and South.
	8" Hickory S72°W 94 links
	5" Burr Oak S16½°E 129 links

LCRC. Oct. 12, 1973 J. King
L.1032 P. 596
Iron over tile 6" below
surface 2.2' West of center
line of road.
NW Cor Tower S.E. 51.0'
Metal Anchor
Post S80°W 24.1'
S. End 14"
CMP N10°E 49.0'


B. Description of corner evidence found and/or method applied in restoring or reestablishing corner:

Found iron 1' West of centerline of road that has been used for several previous surveys.

COMMISSION
REMONUMENTATION

FEB 22 1996

COMMISSION

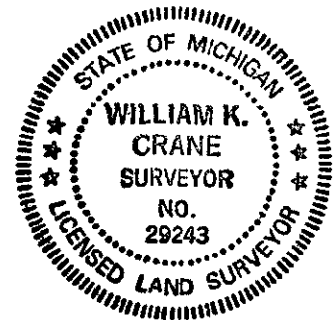

C. Description of monument for corner and accessories established to perpetuate locating the position of the corner:

Replaced iron with Standard Calhoun County Remonumentation Monument (Bernsten Monument) and a monument box.

U.P.	N45°W	31.29'
R.R. TIE		
FNC. COR.	N35°W	43.85'
15" Oak	N35°E	86.20'
12" Pine	East	86.88'

This is accepted as the best available evidence of the position of the original corner.

Signed by William K. Crane
William K. Crane
Surveyor's Michigan License No. # 29243

Date 12/1/95