

APPROVED

Date 10-21-97
CALHOUN COUNTY
REMONUMENTATION.

CALHOUN COUNTY REMONUMENTATION
LAND CORNER RECORDATION CERTIFICATE
Filing Requirement of Act 74, Mich. P.A. 1970

STATE OF MICHIGAN
CALHOUN COUNTY
RECORDED

For corners in

<u>CALHOUN</u>	Located In:	Corner Code #
(County)		
EMMETT TOWNSHIP		
1. Public Land Survey	T <u>2S</u> R <u>7W</u>	<u>M-2</u>
	T _____ R _____	_____
	T _____ R _____	_____
	T _____ R _____	_____
2. Property Controlling	S _____ T _____ R _____	_____
in Section	S _____ T _____ R _____	_____
3. Miscellaneous	S _____ T _____ R _____	_____
Property in Sec.	S _____ T _____ R _____	_____

24 OCT 97 12:01 P.M.

ANNE B. NORLANDER
CLERK - REGISTER OF DEEDS

LIDER 1973 PAGE 179

Register of Deeds Stamp & File Number

4. Lot No. _____, Recorded Plat _____
5. Private Claims _____

I, ROBERT R. CARR, in a field survey on FEBRUARY 28, 19 96 do hereby state that under requirements of P.A. 74, Michigan P.A. of 1970, the corner points mentioned in lines 1 and 2 above were in conformance with regulations and rules therefore as required in the current manual of survey instructions of the United States Department of the Interior, Bureau of Land Management or by a decree of a Court of Law and /or that the corner points mentioned in lines 3, 4 and 5 above were in conformance with the rules of the Michigan Board of Land Surveyors or by a Decree of a Court of Law; established, re-established, monumented, recovered, found as expressed below:

NOTE: Not more than 2 corners, all in the same town and range, may be recorded on this certificate.

A. Description of original monument and accessories and/or subsequent restoration:

1826 G.L.O. SIBLEY
1889 RESURVEY BY HODGMAN, FOUND STAKE STANDING S20dE 18 LINKS
FROM STUMP OF U.S. BEARING TREE AND SET POST (TILE)
TAMARACK 5" N40dW 84 LINKS
5" TAMARACK, S49-1/2dW (DISTANCE NOT LEGIBLE).

	A	B	C	D	E	F	G	H	I	J	K	L	M
1													
2	6		5		4		3		2		1		
3													
4	7		8		9		10		11		12		
5													
6	18		17		16		15		14		13		
7													
8	19		20		21		22		23		24		
9													
10	30		29		28		27		26		25		
11													
12	31		32		33		34		35		36		
13													

SURVEY &
REMONUMENTATION

APR 07 1998


SECTION

B. Description of corner evidence found and/or method applied in restoring or reestablishing corner:

FOUND RESURVEY TILES AT NORTHEAST AND SOUTHEAST CORNERS OF SECTION 1 AND MEASURED 5022.28 FEET BETWEEN (G.L.O. 4989.60 FEET), PRORATED FOR LOCATION OF EAST 1/4 POST AT 2657.29 FEET NORTH OF SOUTHEAST CORNER (G.L.O. 2640 FEET), LOCATION FALLS IN TAMARACK SWAMP AS INDICATED BY G.L.O. AND RESURVEY NOTES. SEARCHED AND DUG FOR TILE, BUT DID NOT FIND. SET EAST 1/4 POST AT PRORATED DISTANCE ON LINE BETWEEN SOUTHEAST AND NORTHEAST CORNERS.

C. Description of monument for corner and accessories established to perpetuate locating the position of the corner:

BERNTSEN MONUMENT OVER 4 FOOT LONG PIPE
CENTERLINE OF ELECTRIC LINE TO EAST IS NORTH 15 FEET.
NAIL AND SPOTTER IN UTILITY POLE, N82dW, 666.43 FEET.
NAIL AND SPOTTER IN UTILITY POLE, N88dE, 148.44 FEET.
NAIL AND SPOTTER IN 30" OAK, N23dE, 308.08 FEET.
NAIL AND SPOTTER IN 16" CHERRY, N11dW, 209.05 FEET.

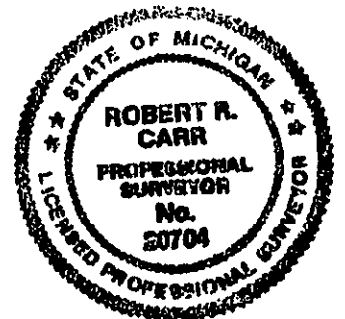

Signed by [Signature]
Surveyor's Michigan License No. 20704

Date OCTOBER 20, 1997