

**APPROVED**

Date DEC 6, 1995  
**CALHOUN COUNTY  
REMONUMENTATION.**

**CALHOUN COUNTY REMONUMENTATION  
LAND CORNER RECORDATION CERTIFICATE**  
Filing Requirement of Act 74, Mich. P.A. 1970

STATE OF MICHIGAN  
CALHOUN COUNTY  
RECORDED

12 DEC 95 11:00 A.M.

ANNE B. NORLANDER  
CLERK - REGISTER OF DEEDS

**LIBER 1835 PAGE 420**

**Register of Deeds Stamp & File Number**

<b>CALHOUN</b> (County)	Located In:	Corner Code #
<b>EMMETT TWP</b>		
1. Public Land Survey	T <u>2</u> S R <u>7</u> W	<u>M-3</u>
	T _____ R _____	_____
	T _____ R _____	_____
	T _____ R _____	_____
2. Property Controlling in Section	S _____ T _____ R _____	_____
	S _____ T _____ R _____	_____
3. Miscellaneous Property in Sec.	S _____ T _____ R _____	_____
	S _____ T _____ R _____	_____
4. Lot No. _____, Recorded Plat _____		
5. Private Claims _____		

	A	B	C	D	E	F	G	H	I	J	K	L	M
2	6		5		4		3		2		1		
3													
4	7		8		9		10		11		12		
5													
6	18		17		16		15		14		13		
7													
8	19		20		21		22		23		24		
9													
10	30		29		28		27		26		25		
11													
12	31		32		33		34		35		36		
13													

I, **ROBERT R. CARR** in a field survey on **NOVEMBER 30**, 19 **95**, do hereby certify that under requirements of P.A. 74, Michigan P.A. of 1970, the corner points mentioned in lines 1 and 2 above were in conformance with regulations and rules therefore as required in the current manual of survey instructions of the United States Department of the Interior, Bureau of Land Management or by a decree of a Court of Law and/or that the corner points mentioned in lines 3, 4 and 5 above were in conformance with the rules of the Michigan Board of Land Surveyors or by a Decree of a Court of Law; established, re-established, monumented, re-monumented, recovered, found as expressed below:

**NOTE: Not more than 4 corners, all in the same town and range, may be recorded on this certificate.**

A. Description of original monument and accessories and/or subsequent restoration:


**G.L.O. SIBLEY 1826**  
**RESURVEY BY HODGEMAN, 1889, FOUND STAKE STANDING IN SWAMP**  
**ONE U.S. BEARING TREE REMAINING, SET POST**  
**TAMARACK 6" N15-1/2°E 22-3/4 LKS TAMARACK 4" S59-1/2°E 9-1/2 LKS**  
**MARSHALL CORNER SOUTH 68 LKS**

B. Description of corner evidence found and/or method applied in restoring or reestablishing corner:  
**FOUND RESURVEY TILE BY HODGEMAN NO WITNESSES REMAINING**  
**ALSO FOUND MARSHALL TILE 68 LKS SOUTH**

**CONFIRMATION  
REMONUMENTATION**

**FEB 22 1996**

**COMMISSION**

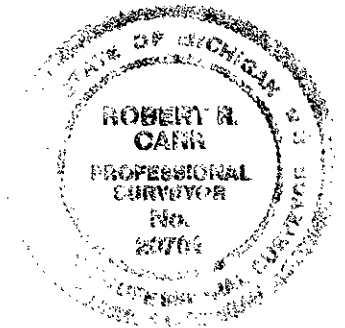

C. Description of monument for corner and accessories established to perpetuate locating the position of the corner:  
**REMOVED TOP TILE AND REPLACED WITH BERNTSEN CALHOUN COUNTY REMONUMENT**  
**MONUMENT WITH CARSONITE WITNESS POST BESIDE.**

**NAIL & SPOTTER SOUTHERLY SIDE OF 10" MAPLE S58°E 59.01 FEET**  
**NAIL & SPOTTER SOUTHERLY SIDE OF 10" MAPLE N63°E 30.13 FEET**  
**NAIL & SPOTTER EASTERLY SIDE OF TWIN 6"-8" MAPLE N18°E 47.3 FEET**  
**NAIL & SPOTTER NORTHERLY SIDE OF 8" MAPLE N58°W 14.99 FEET**  
**TILE AT SW CORNER OF SECTION 6 T2S R6W SOUTHERLY 44.88 FEET.**

Signed by *Robert R. Carr*  
**ROBERT R. CARR**  
Surveyor's Michigan License No. 20704

Date DECEMBER 6, 1995