

APPROVED ¹⁰⁸⁴⁰

Date Aug. 21 1996
CALHOUN COUNTY
REMONUMENTATION.

CALHOUN COUNTY REMONUMENTATION
LAND CORNER RECORDATION CERTIFICATE
Filing Requirement of Act 74, Mich. P.A. 1970

STATE OF MICHIGAN
CALHOUN COUNTY
RECORDED

24 SEP 96 10:54 A.M.

ANNE B. NDRLANDER
CLERK - REGISTER OF DEEDS

Register of Deeds Stamp & File Number

For corners in
Calhoun
Emmett Twp. (County)

Located In: Corner Code #:

1. Public Land Survey	T <u>2</u> S R <u>7</u> W	<u>M-8</u>
	T _____ R _____	_____
	T _____ R _____	_____
	T _____ R _____	_____
2. Property Controlling in Section	S _____ T _____ R _____	_____
	S _____ T _____ R _____	_____
3. Miscellaneous Property in Sec.	S _____ T _____ R _____	_____
	S _____ T _____ R _____	_____

4. Lot No. _____, Recorded Plat _____

5. Private Claims _____

	A	B	C	D	E	F	G	H	I	J	K	L	M
2	6	5	4	3	2	1							
3													
4	7	8	9	10	11	12							
5													
6	18	17	16	15	14	13							
7													
8	19	20	21	22	23	24							
9													
10	30	29	28	27	26	25							
11													
12	31	32	33	34	35	36							
13													

Emmett Twp.

Donald J. Davis in a field survey on August 10, 1996, do hereby certify that under requirements of P.A. 74, Michigan P.A. of 1970, the corner points mentioned in lines 1 and 2 above were in conformance with regulations and rules therefore as required in the current manual of survey instructions of the United States Department of the Interior, Bureau of Land Management or by a decree of a Court of Law and/or that the corner points mentioned in lines 3, 4 and 5 above were in conformance with the rules of the Michigan Board of Land Surveyors or by a Decree of a Court of Law; established, re-established, monumented, re-monumented, recovered, found as expressed below:

NOTE: Not more than 4 corners, all in the same town and range, may be recorded on this certificate.

A. Description of original monument and accessories and/or subsequent restoration:

Original survey in 1826 by Sibley.
10" White Oak N 32° W 7.47 links.
18" Yellow Oak N 4½° W 4.19 links

Resurvey in 1889 by Hodgeman, Tile set.

1976 survey by Davis, tile found in marsh, 18.9' north of East and West fence.
Pipe and fence post set by tile.

B. Description of corner evidence found and/or method applied in restoring or reestablishing corner:
Found tile and iron as set and used on survey in 1976.

Accepted as good perpetuation of original corner location.


SURVEY &
REMONUMENTATION
MAR 21 1997
COMMISSION

LIBER 1887 PAGE 963

C. Description of monument for corner and accessories established to perpetuate locating the position of the corner:

Set Berntsen monument and grafite marker 34.4' north of East and West fence.

Nail & Tag 8" Poplar N 20° E 108.8'
Nail & Tag Tree of Heaven West 151.60'
Nail & Tag 8" Poplar S 10° W 98.15'
Nail & Tag 8" Poplar S 25° E 96.00'

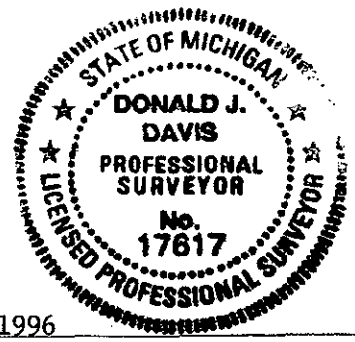

Signed by Donald J. Davis
Donald J. Davis
Surveyor's Michigan License No. 17617

Date August 12, 1996