

REMONUMENTATION

FEB 22 1996

COMMISSION

Calhoun County Remonumentation
LAND CORNER RECORDATION CERTIFICATE
Filing Requirement of Act 74, Mich. P.A. 1970

APPROVED
Date May 17, 1995
CALHOUN COUNTY
REMONUMENTATION.

For corners in

CALHOUN (County)	Located In:	Corner Code #
1. Public Land Survey	T 2S R 8W	C1
	T R	
	T R	
	T R	
2. Property Controlling in Section	S T R	
	S T R	
3. Miscellaneous Property in Sec.	S T R	
	S T R	
4. Lot No. _____, Recorded Plat _____		
5. Private Claims _____		

STATE OF MICHIGAN
CALHOUN COUNTY
RECORDED

22 MAY 95 10:55 A.M.

ANNE B. NORLANDER
CLERK - REGISTER OF DEEDS

Register of Deeds Stamp & File Number

	A	B	C	D	E	F	G	H	I	J	K	L	M
2	6		5		4		3		2		1		
3													
4	7		8		9		10		11		12		
5													
6	18		17		16		15		14		13		
7													
8	19		20		21		22		23		24		
9													
10	30		29		28		27		26		25		
11													
12	31		32		33		34		35		36		
13													

I, William K. Crane, in a field survey on May 1, 19 95, do hereby certify that under requirements of P.A. 74, Michigan P.A. of 1970, the corner points mentioned in lines 1 and 2 above were in conformance with regulations and rules therefore as required in the current manual of survey instructions of the United States Department of the Interior, Bureau of Land Management or by a decree of a Court of Law and/or that the corner points mentioned in lines 3, 4 and 5 above were in conformance with the rules of the Michigan Board of Land Surveyors or by a Decree of a Court of Law; established, re-established, monumented, re-monumented, recovered, found as expressed below:

NOTE: Not more than 4 corners, all in the same town and range, may be recorded on this certificate.

A. Description of original monument and accessories and/or subsequent restoration:

Original Government Field Notes
(S. Sibley 1826)

26" Br. Oak S 61° E 80 Links
26" Br. Oak S 50° W 234 Links

Resurvey by F. Hodgman in 1889
Set post 184 links East of Bedford
Corner

10" Burr Oak S 58° E 87½ Links
12" Black Oak N 75° W 84 Links

B. Description of corner evidence found and/or method applied in restoring or reestablishing corner:

Records of Dekeyser & Assoc.
(1971 Phil McPherson)
R.R. Spike

U. Pole N 70° W 61.77'
U. Pole S 60° W 65.77'
U. Pole S 68° E 97.20"
5.4' E of Centerline Hill Rd.
4.9' N of Centerline Harmonia Rd.

(This is accepted as the best available evidence of the position of the original corner.)

C. Description of monument for corner and accessories established to perpetuate locating the position of the corner:

Replaced rered with Standard Calhoun County Remonumentation corner.
(Bernsten Monument)

Concrete light pole base	N 37° E	151.52'
Concrete light pole base	S 20° W	108.04'
10" Pine	S 10° W	57.00'
8" Pine	S 15° E	97.67'
Bedford Corner	West	121.41'

LCRC L.3 P.809
(1994 Wetoskey)

Found 5/8" iron, placed cap
#19847

Conc. Lite N 37° E 151.52'

Pole Base

Conc. Lite N 25° W 108.04'

Pole Base

10" Conifer S 55° W 67.70'


Tree

12" Conifer S 18° E 56.35'

Tree

Bed. Cor. West 121.40'

Found rered wit
cap # 19847 and
corner witness
per LCRC in L.3
P. 809

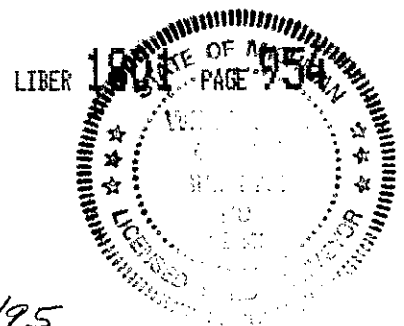

Signed by William K Crane

Date 5/17/95

Surveyor's Michigan License No. 29243