

250

REMONUMENTATION

FEB 22 1996
COMMISSION

CALHOUN COUNTY REMONUMENTATION LAND CORNER RECORDATION CERTIFICATE Filing Requirement of Act 74, Mich. P.A. 1970

APPROVED

Date Nov. 20 1995
CALHOUN COUNTY
REGISTER OF DEEDS
CALHOUN COUNTY
RECORDED

4 DEC 95 2:26 P.M.

ANNE B. NORLANDER
CLERK - REGISTER OF DEEDS

For corners in

CALHOUN
(County)
BATTLE CREEK CITY

Located In:

Corner Code #/

1. Public Land Survey	T <u>2</u> SR <u>8</u> W	<u>C-3</u>
	T ___ R ___	_____
	T ___ R ___	_____
	T ___ R ___	_____
2. Property Controlling in Section	S ___ T ___ R ___	_____
	S ___ T ___ R ___	_____
3. Miscellaneous Property in Sec.	S ___ T ___ R ___	_____
	S ___ T ___ R ___	_____

Register of Deeds Stamp & File Number

- 4. Lot No. _____, Recorded Plat _____
- 5. Private Claims _____

I, ROBERT R. CARR in a field survey on OCTOBER 24, 19 95

do hereby certify that under requirements of P.A. 74, Michigan P.A. of 1970, the corner points mentioned in lines 1 and 2 above were in conformance with regulations and rules therefore as required in the current manual of survey instructions of the United States Department of the Interior, Bureau of Land Management or by a decree of a Court of Law and/or that the corner points mentioned in lines 3, 4 and 5 above were in conformance with the rules of the Michigan Board of Land Surveyors or by a Decree of a Court of Law; established, re-established, monumented, re-monumented, recovered, found as expressed below.

NOTE: Not more than 4 corners, all in the same town and range, may be recorded on this certificate.

	A	B	C	D	E	F	G	H	I	J	K	L	M
2	6		5		4		3		2		1		
3		7	8		9		10		11		12		
4	7		8		9		10		11		12		
5													
6	18		17		16		15		14		13		
7													
8	19		20		21		22		23		24		
9													
10	30		29		28		27		26		25		
11													
12	31		32		33		34		35		36		
13													

A. Description of original monument and accessories and/or subsequent restoration:

GLO, SIBLEY, 1826.
 HODGEMAN, 1889, FOUND OLD STAKE AT INTERSECTION OF ROADS NORTH, EAST & WEST, SET TILE.
 NO NAME, DATE OR DESCRIPTION, THREE WITNESSES TO CONCRETE PILLARS.
 EAST SIDE ± OF CONCRETE PILLARS, 9.8 FT NORTH OF CONCRETE PILLAR,
 10.4 FT SOUTH OF CONCRETE PILLAR.
 LCRC BY CRANE, LIBER 1583, PG 549.
 BATTLE CREEK-FORT CUSTER URBAN RENEWAL PLAT NO 2.


B. Description of corner evidence found and/or method applied in restoring or reestablishing corner:

CRANE FOUND CORNER DESTROYED BY CONSTRUCTION AND RE-SET 1/2 IRON FROM SURVEYS TIED TO CORNER
 HAVING KNOWLEDGE OF THIS CORNER HAVING BEEN USED FOR MANY SURVEYS OVER THE PAST 25 YEARS, SOME WHEN THE CONCRETE PILLARS MENTIONED ABOVE WERE IN PLACE, I BELIEVE THE LOCATION ESTABLISHED BY CRANE TO BE A FAITHFUL PERPETUATION OF THE CORNER.

LIBER 1834 PAGE 255

C. Description of monument for corner and accessories established to perpetuate locating the position of the corner:

BERNTSEN CALHOUN COUNTY REMON MONUMENT WITH BRICKS AND STONE AROUND.
 CARSONITE WITNESS POST EAST 1.0 FOOT; NE CORNER OF CONCRETE PILLAR, S16°E, 9.97 FEET.
 NAIL & SPOTTER IN 20" WALNUT, S77°E, 407.12 FEET.
 NAIL & SPOTTER IN 14" WALNUT, S53°E, 126.52 FEET.
 NAIL & SPOTTER IN 24" WALNUT, S87°W, 303.48 FEET.

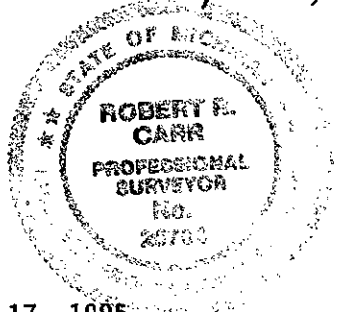

Signed by Robert R. Carr
 Surveyor's Michigan License No. 20704

Date NOVEMBER 17, 1995