

250  
REMONUMENTATION

FEB 22 1996  
COMMISSION

CALHOUN COUNTY REMONUMENTATION  
LAND CORNER RECORDATION CERTIFICATE  
Filing Requirement of Act 74, Mich. P.A. 1970

APPROVED  
Date Nov 20 1995  
CALHOUN COUNTY  
REGISTER OF DEEDS  
RECORDATION  
RECORDED

For corners in

CALHOUN  
(County)  
BATTLE CREEK CITY

Located in: Corner Code #

1. Public Land Survey	T <u>2</u> SR <u>8</u> W	<u>C-5</u>
	T _____ R _____	_____
	T _____ R _____	_____
	T _____ R _____	_____
2. Property Controlling in Section	S _____ T _____ R _____	_____
	S _____ T _____ R _____	_____
3. Miscellaneous Property in Sec.	S _____ T _____ R _____	_____
	S _____ T _____ R _____	_____

4 DEC 95 2:26 P.M.

ANNE B. NORLANDER  
CLERK - REGISTER OF DEEDS

Register of Deeds Stamp & File Number

- 4. Lot No. \_\_\_\_\_, Recorded Plat \_\_\_\_\_
- 5. Private Claims \_\_\_\_\_

I, ROBERT R. CARR in a field survey on SEPTEMBER 1, 19 95, do hereby certify that under requirements of P.A. 74, Michigan P.A. of 1970, the corner points mentioned in lines 1 and 2 above were in conformance with regulations and rules therefore as required in the current manual of survey instructions of the United States Department of the Interior, Bureau of Land Management or by a decree of a Court of Law and/or that the corner points mentioned in lines 3, 4 and 5 above were in conformance with the rules of the Michigan Board of Land Surveyors or by a Decree of a Court of Law; established, re-established, monumented, re-monumented, recovered, found as expressed below.

NOTE: Not more than 4 corners, all in the same town and range, may be recorded on this certificate.


	A	B	C	D	E	F	G	H	I	J	K	L	M
2	6		5		4		3		2		1		
3													
4	7		8		9		10		11		12		
5													
6	18		17		16		15		14		13		
7													
8	19		20		21		22		23		24		
9													
10	30		29		28		27		26		25		
11													
12	31		32		33		34		35		36		
13													

A. Description of original monument and accessories and/or subsequent restoration:

GLO, SIBLEY, 1826.  
 HODGEMAN, 1889, FOUND STAKE WITH STONE AROUND, FROM STUMP OF U.S. BEARING TREE AND SET TILE.  
 NO NAME OR DATE, IRON, 18" OAK WEST 13.2 FEET (CLUMP OF 4) 14" OAK S45°W 17.3 FEET (CLUMP OF 3).  
 NO NAME, 1961, 4" IRON WITH CAP, THREE WITNESSES  
 L.C.R.C. BY CRANE, LIBER 1583, PG 550, FOUND 4" PIPE.

B. Description of corner evidence found and/or method applied in restoring or reestablishing corner:

FOUND 4" PIPE WITH CAP PER LCRC LIBER 1583, PG 550.  
 ACCEPTED AS TRUE PERPETUATION OF CORNER.

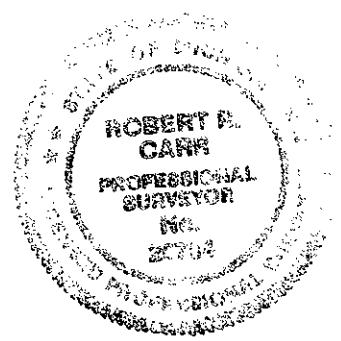

C. Description of monument for corner and accessories established to perpetuate locating the position of the corner:

LEFT 4" PIPE WITH CAP IN PLACE.  
 PLACED CARSONITE WITNESS POST NORTH 2.0 FEET.  
 CONCRETE MONUMENT, N05°E, 40.18 FEET.  
 CONCRETE MONUMENT, S05°W, 39.65 FEET.  
 TRIPLE OAK, N76°W, 13.73 FEET.  
 NAIL & SPOTTER IN 14" BLACK CHERRY, N83°E, 96.19 FEET.  
 NAIL & SPOTTER IN 8" OAK, N48°E, 44.16 FEET.  
 NAIL & SPOTTER IN 16" OAK, N41°W, 18.33 FEET. NORTH/SOUTH FENCE WEST 11.0 FEET.

LIBER 1834 PAGE 256

Signed by Robert R. Carr Date NOVEMBER 17, 1995  
 Surveyor's Michigan License No. 20704