

REMONUMENTATION

FEB 22 1996

COMMISSION

CALHOUN COUNTY REMONUMENTATION
LAND CORNER RECORDATION CERTIFICATE
Filing Requirement of Act 74, Mich. P.A. 1970

APPROVED
Date May 17, 1995
CALHOUN COUNTY
REMONUMENTATION.

For corners in

CALHOUN (County)	Located In:	Corner Code -#
1. Public Land Survey	T <u>2S</u> R <u>8W</u>	<u>D1</u>
	T _____ R _____	_____
	T _____ R _____	_____
	T _____ R _____	_____
2. Property Controlling in Section	S _____ T _____ R _____	_____
	S _____ T _____ R _____	_____
3. Miscellaneous Property in Sec.	S _____ T _____ R _____	_____
	S _____ T _____ R _____	_____
4. Lot No. _____, Recorded Plat _____		
5. Private Claims _____		

STATE OF MICHIGAN
CALHOUN COUNTY
RECORDED

22 MAY 95 10:54 A.M.

ANNE B. NORLANDER
CLERK - REGISTER OF DEEDS
Register of Deeds Stamp & File Number

	A	B	C	D	E	F	G	H	I	J	K	L	M
2	6	5	4	3	2	1							
3													
4	7	8	9	10	11	12							
5													
6	18	17	16	15	14	13							
7													
8	19	20	21	22	23	24							
9													
10	30	29	28	27	26	25							
11													
12	31	32	33	34	35	36							
13													

I, William K. Crane, in a field survey on May 1, 1995, do hereby certify that under requirements of P.A. 74, Michigan P.A. of 1970, the corner points mentioned in lines 1 and 2 above were in conformance with regulations and rules therefore as required in the current manual of survey instructions of the United States Department of the Interior, Bureau of Land Management or by a decree of a Court of Law and/or that the corner points mentioned in lines 3, 4 and 5 above were in conformance with the rules of the Michigan Board of Land Surveyors or by a Decree of a Court of Law; established, re-established, monumented, re-monumented, recovered, found as expressed below:

NOTE: Not more than 4 corners, all in the same town and range, may be recorded on this certificate.

A. Description of original monument and accessories and/or subsequent restoration:

Not set in original government survey. Records of DeKeyser & Associates indicate a 4" pipe with cap 109.13' East of the Bedford corner. (Dated 1958). 4" pipe gone. Found 1/2" rerod matching distance from Bedford corner. Recorded in LCRC dated July 1991 by William K. Crane.

B. Description of corner evidence found and/or method applied in restoring or reestablishing corner:

Found 1/2" rerod as previously recorded and matching distance from Bedford corner.


LIBER 1801 PAGE 950

C. Description of monument for corner and accessories established to perpetuate locating the position of the corner:

Replaced rerod with standard Calhoun County Remonumentation corner (Bernsten Monument)

10" Pine	S 75° E	43.10'
Utility Pole	S 20° W	61.00'
15" Cherry	N 10° W	53.70'
10" Pine	East	105.10'
Bedford Corner	West	109.13'

Signed by William K Crane
Surveyor's Michigan License No. 29243

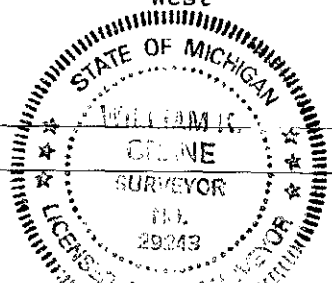

Date 5/17/95