

REMONUMENTATION

FEB 22 1996

COMMISSION

CALHOUN COUNTY REMONUMENTATION  
LAND CORNER RECORDATION CERTIFICATE  
Filing Requirement of Act 74, Mich. P.A. 1970

APPROVED

Date Sept 20 1995  
CALHOUN COUNTY  
REMONUMENTATION.

For corners in

CALHOUN (County)	Located In:	Corner Code #
BATTLE CREEK CITY 1. Public Land Survey	T 2 S R 8 W	D-7
	T ___ R ___	_____
	T ___ R ___	_____
	T ___ R ___	_____
2. Property Controlling in Section	S ___ T ___ R ___	_____
	S ___ T ___ R ___	_____
3. Miscellaneous Property in Sec.	S ___ T ___ R ___	_____
	S ___ T ___ R ___	_____
4. Lot No. _____, Recorded Plat _____		
5. Private Claims _____		

STATE OF MICHIGAN  
CALHOUN COUNTY  
RECORDED

22 SEP 95 10:02 A.M.

ANNE B. NORLANDER  
Register of Deeds

	A	B	C	D	E	F	G	H	I	J	K	L	M
2	6		5		4		3		2		1		
3													
4	7		8		9		10		11		12		
5													
6	18		17		16		15		14		13		
7			19		20		21		22		23		24
8													
9													
10	30		29		28		27		26		25		
11													
12	31		32		33		34		35		36		
13													

ROBERT R. CARR, in a field survey on AUGUST 14, 19 95, hereby certify that under requirements of P.A. 74, Michigan P.A. of 1970, the corner points mentioned in lines 1 and 2 above were in conformance with regulations and rules therefore as required in the current manual of survey instructions of the United States Department of the Interior, Bureau of Land Management or by a decree of a Court of Law and/or that the corner points mentioned in lines 3, 4 and 5 above were in conformance with the rules of the Michigan Board of Land Surveyors or by a Decree of a Court of Law; established, re-established, monumented, re-monumented, recovered, found as expressed below:


NOTE: Not more than 4 corners, all in the same town and range, may be recorded on this certificate.

Description of original monument and accessories and/or subsequent restoration:  
SOUTH 1/4 POST SECTION 17 TOWN 2 SOUTH. RANGE 8 WEST  
ORIGINAL CORNER SET BY SYLVESTER SIBLEY 1826.  
F. HODGEMAN FOUND OLD STAKE AND SET POST (TILE) 1889.  
TILE FOUND 1946 (SURVEYORS NAME NOT KNOWN).

Description of corner evidence found and/or method applied in restoring or reestablishing corner:  
FOUND CONCRETE MONUMENT MATCHING 1946 WITNESSES TO TILE.

LINER 1822 PAGE 33

Description of monument for corner and accessories established to perpetuate locating the position of the corner:  
RE-PLACED CONCRETE MONUMENT WITH CALHOUN COUNTY REMONUMENTATION CORNER (BERNTSEN MONUMENT) WITH CARSONITE WITNESS POST BESIDE.  
1 FOOT EAST OF FENCE AND 8 FEET EAST OF OLD FALLEN WOOD POST.  
NAIL & SPOTTER IN SOUTHERLY SIDE OF 28" CHERRY S68°E 35.50 FEET.  
NAIL & SPOTTER IN SOUTHWESTERLY SIDE OF 26" OAK S45°E 19.52 FEET.  
NAIL & SPOTTER IN EAST SIDE OF 18" CHERRY S15°E 18.04 FEET.  
NAIL & SPOTTER IN NORTHWESTERLY SIDE OF 5" OAK S55°W 14.64 FEET.  
NAIL & SPOTTER IN NORTH SIDE OF 10" HICKORY N88°W 35.94 FEET.

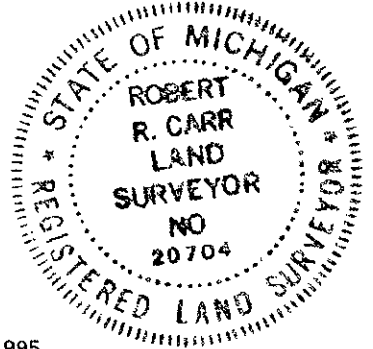

signed by Robert R. Carr  
Surveyor's Michigan License No. 20704

Date SEPTEMBER 20, 1995