

REMONUMENTATION

FEB 22 1996

COMMISSION


For corners in

CALHOUN COUNTY REMONUMENTATION
LAND CORNER RECORDATION CERTIFICATE
Filing Requirement of Act 74, Mich. P.A. 1970

APPROVED
Date Dec 18 1995
CALHOUN COUNTY
REMONUMENTATION.

Calhoun (County)	Located In:	Corner Code #
1. Public Land Survey	T 2 S R 8 W	E-1
	T _____ R _____	_____
	T _____ R _____	_____
	T _____ R _____	_____
2. Property Controlling in Section	S _____ T _____ R _____	_____
	S _____ T _____ R _____	_____
3. Miscellaneous Property in Sec.	S _____ T _____ R _____	_____
	S _____ T _____ R _____	_____
4. Lot No. _____, Recorded Plat _____		
5. Private Claims _____		

STATE OF MICHIGAN
CALHOUN COUNTY
RECORDED
26 OCT 95 10:02 A.M.
ANNE B. NORLANDER
Register of Deeds Stamp & File Number

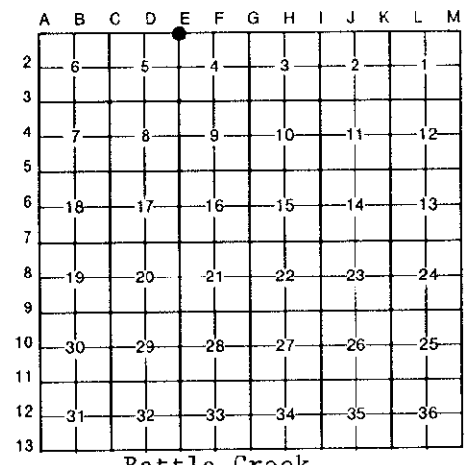

I, William K. Crane, in a field survey on October 16, 19 95, do hereby certify that under requirements of P.A. 74, Michigan P.A. of 1970, the corner points mentioned in lines 1 and 2 above were in conformance with regulations and rules therefore as required in the current manual of survey instructions of the United States Department of the Interior, Bureau of Land Management or by a decree of a Court of Law and/or that the corner points mentioned in lines 3, 4 and 5 above were in conformance with the rules of the Michigan Board of Land Surveyors or by a Decree of a Court of Law: established, re-established, monumented, re-monumented, recovered, found as expressed below:

NOTE: Not more than 4 corners, all in the same town and range, may be recorded on this certificate.

A. Description of original monument and accessories and/or subsequent restoration:

Original Government Field Notes
(S. Sibley 1826):
3" W. Oak S40°W 1267 links
2" W. Oak S01°W 939 links

Resurvey by F. Hodgman (1889):
Set post on township line with old fence and 153 links East of old ditch line.
6" Aspen N80°W 276½ links

Undated Dekeyser & Assoc. records indicate tile 100.9' East of Bedford Corner
12" Walnut S78°E 97.9'
12" Elm S57°E 38.0'
12" Elm S71°W 69.7'

B. Description of corner evidence found and/or method applied in restoring or reestablishing corner:

Found State of Michigan brass cap monument in 4" pipe with concrete 100.98 feet East of Bedford Corner.


LIDER 1826 PAGE 39

C. Description of monument for corner and accessories established to perpetuate locating the position of the corner:

Left State of Michigan monument in place and set a monument box over it. (3'± South of centerline of bituminous road).

- Utility pole S70°E 42.32'
- 6" Box Elder S10°W 16.89'
- Utility pole S60°W 96.18'
- Speed limit sign N45°W 28.73'
- Bedford Corner West 100.98'

This is accepted as the best available evidence of the position of the original corner...

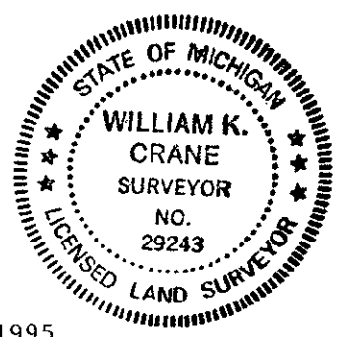

Signed by William K. Crane Date October 18, 1995
Surveyor's Michigan License No. 29243