

REMONUMENTATION

FEB 22 1996

CALHOUN COUNTY REMONUMENTATION

COMMISSION

LAND CORNER RECORDATION CERTIFICATE
Filing Requirement of Act 74, Mich. P.A. 1970

APPROVED
Date Nov. 20, 1995
CALHOUN COUNTY
REMONUMENTATION.

STATE OF MICHIGAN
CALHOUN COUNTY
RECORDED

4 DEC 95 2:22 P.M.

ANNE B. NORLANDER
CLERK - REGISTER OF DEEDS

Register of Deeds Stamp & File Number

For corners in

Calhoun (County)	Located In:	Corner Code #
City of Battle Creek		
1. Public Land Survey	T 2 S R 8 W	E-2
	T ___ R ___	_____
	T ___ R ___	_____
	T ___ R ___	_____
2. Property Controlling in Section	S ___ T ___ R ___	_____
	S ___ T ___ R ___	_____
3. Miscellaneous Property in Sec.	S ___ T ___ R ___	_____
	S ___ T ___ R ___	_____
4. Lot No. _____, Recorded Plat _____		
5. Private Claims _____		

I, William K. Crane, in a field survey on November 10, 1995, do hereby certify that under requirements of P.A. 74, Michigan P.A. of 1970, the corner points mentioned in lines 1 and 2 above were in conformance with regulations and rules therefore as required in the current manual of survey instructions of the United States Department of the Interior, Bureau of Land Management or by a decree of a Court of Law and/or that the corner points mentioned in lines 3, 4 and 5 above were in conformance with the rules of the Michigan Board of Land Surveyors or by a Decree of a Court of Law; established, re-established, monumented, re-monumented, recovered, found as expressed below:

NOTE: Not more than 4 corners, all in the same town and range, may be recorded on this certificate.

A. Description of original monument and accessories and/or subsequent restoration:

Original Government Survey
(S. Sibley, 1826):

7" W. Oak S 14° W 6 links
9" W. Oak N 42° W 11 links

Re-survey, F. Hodgman, 1889:

East 1/4 Post lost. Mr. Lawler and Mr. Austin say the fences North and West were set on line by survey when the corner was good. Set post at intersection of fences.

16" R. Oak N 12 links
16" R. Oak S 77½° W 30½ links

L.W. Chase, 1948:

Found metal pipe over tile.

7" W.O. S 14° W 3.9'
19" W.O. N 42° W 7.2'
Cor. Fence W 1.0'
Post
Twin Oak N 75° W 23.4'
Db1. Cherry N 35° W 33.1'

B. Description of corner evidence found and/or method applied in restoring or reestablishing corner:

Unable to locate any witnesses. Ran traverse to corners E-1, E-3 and G-2. Computed location based on distances from survey by Paul Saltzgaber in 1954. Dug at computed location and found remains of old fence post with wire wrapped around it. More excavation revealed several pieces of the broken clay tile. Set corner 1 foot East of old fence post and in the middle of the pieces of broken clay tile. Measurements from this corner per our traverse are as follows:


E-2 to E-1: N 00°18'50" W 2449.73'
E-2 to E-3: S 00°03'39" W 2662.31'
E-2 to G-2: N 89°59'12" E 5244.12'

LIBER 1834 PAGE 251

C. Description of monument for corner and accessories established to perpetuate locating the position of the corner:
Set standard Calhoun County Remonumentation Corner (Bernsten Monument).

U. Pole North 80.41'
8" Walnut S 56° W 49.89'
8" Cherry N 40° W 32.78'
NE Corner
RR Tie Bridge S 11° W 55.80'

This is accepted as a careful and faithful perpetuation of the position of the original corner.

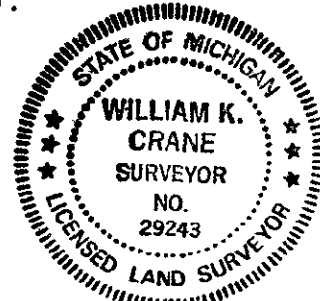

Signed by William K. Crane Date November 20, 1995
Surveyor's Michigan License No. 29243