

SURVEY & REMONUMENTATION

MAR 21 1997

APPROVED
Date July 17 1996
**CALHOUN COUNTY
REMONUMENTATION.**

CALHOUN COUNTY REMONUMENTATION COMMISSION

LAND CORNER RECORDATION CERTIFICATE Filing Requirement of Act 74, Mich. P.A. 1970

STATE OF MICHIGAN
CALHOUN COUNTY
RECORDED

24 JUL 96 2:02 P.M.

WILLIAM B. NORLANDER
CLERK - REGISTER OF DEEDS

Register of Deeds Stamp & File Number

For corners in

CALHOUN
(County)

Located In: City of Battle Creek Corner Code #

1. Public Land Survey	Sec 8	T	2S.	R	8W	E-4
		T		R		
		T		R		
		T		R		
2. Property Controlling	S	T		R		
in Section	S	T		R		
3. Miscellaneous	S	T		R		
Property in Sec.	S	T		R		

4. Lot No. _____, Recorded Plat _____

5. Private Claims _____

T2S R8W

	A	B	C	D	E	F	G	H	I	J	K	L	M
2	6	5	4	3	2	1							
3													
4	7	8	9	10	11	12							
5													
6	18	17	16	15	14	13							
7													
8	19	20	21	22	23	24							
9													
10	30	29	28	27	26	25							
11													
12	31	32	33	34	35	36							
13													

I, Robert R. Carr, in a field survey on July 11, 1996, do hereby certify that under requirements of P.A. 74, Michigan P.A. of 1970, the corner points mentioned in lines 1 and 2 above were in conformance with regulations and rules therefore as required in the current manual of survey instructions of the United States Department of the Interior, Bureau of Land Management or by a decree of a Court of Law and/or that the corner points mentioned in lines 3, 4 and 5 above were in conformance with the rules of the Michigan Board of Land Surveyors or by a Decree of a Court of Law; established, re-established, monumented, re-monumented, recovered, found as expressed below:


NOTE: Not more than 4 corners, all in the same town and range, may be recorded on this certificate.

- A. Description of original monument and accessories and/or subsequent restoration:
- GLO, SIBLEY, 1826: Hickory, 8", S56E, 108 lks; W. Oak, 13", N57W, 132 lks.
 - HODGEMAN, 1889: Found old stake hole & bearing tree by Pratt, set post, yellow oak, 8", S74E, 31 lks; black oak, S86-3/4W, 56 lks (Pratt).
 - 1936, No Name: Tile, R.R. spike on top. (7 witnesses).
 - DAVIS, 1983: Found corner 2642.28 North of SE corner Section 8.
 - LCRC, 1991, CRANE: Liber 1556, page 437: found R.R. spike and one witness from 1936.

- B. Description of corner evidence found and/or method applied in restoring or reestablishing corner:
- Recent construction in area, all witnesses gone;
measured North Davis distance from SE corner Section 8, dug and found R.R. spikes, large washers, brick, stone & 1" iron pipe over solid tile.
Excepted tile as true perpetuation of corner.

LIBER 1876 PAGE 172

- C. Description of monument for corner and accessories established to perpetuate locating the position of the corner:
- Set Berntsen Monument in monument box over tile.
 - East edge of bituminous drive West 1'±.
 - SW corner of masonry building (National Guard Fire House), S48°E, 493.92'.
 - NW corner of masonry building S66°E, 461.48'.
 - NW corner of old concrete block building, S13°E, 287.02'.
 - Center of top of monitoring well S49°W, 435.49'.
 - Center of top of monitoring well S75°W, 117.56'.
 - SW corner of large concrete slab, N49°E, 241.97'.

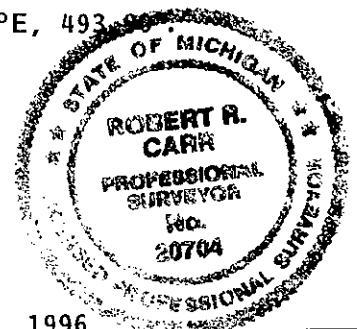

Signed by Robert R. Carr Date July 16, 1996
Surveyor's Michigan License No. 20704