

APPROVED
 JUL 17 1996
CALHOUN COUNTY
REMONUMENTATION.

CALHOUN COUNTY REMONUMENTATION
LAND CORNER RECORDATION CERTIFICATE
 Filing Requirement of Act 74, Mich. P.A. 1970

STATE OF MICHIGAN
 CALHOUN COUNTY
 RECORDED

24 JUL 96 2:02 P.M.

ANNE D. NORLANDER
 CLERK - REGISTER OF DEEDS

For corners in

CALHOUN (County)
City of Battle Creek

1. Public Land Survey Sec 8 T 2S R 8W Corner Code E-5

2. Property Controlling in Section S T R
 S T R
 S T R
 S T R

3. Miscellaneous Property in Sec. S T R
 S T R

4. Lot No. _____, Recorded Plat _____

5. Private Claims _____

SURVEY & REMONUMENTATION

Register of Deeds Stamp & File Number
 MAR 21 1997

T2S R8W

	A	B	C	D	E	F	G	H	I	J	K	L	M
2	6	5	4	3	2	1							
3													
4	7	8	9	10	11	12							
5													
6	18	17	16	15	14	13							
7													
8	19	20	21	22	23	24							
9													
10	30	29	28	27	26	25							
11													
12	31	32	33	34	35	36							
13													

Robert R. Carr, in a field survey on July 11, 1996, to hereby certify that under requirements of P.A. 74, Michigan P.A. of 1970, the corner points mentioned in lines 1 and 2 above were in conformance with regulations and rules therefore as required in the current manual of survey instructions of the United States Department of the Interior, Bureau of Land Management or by a decree of a Court of Law and/or that the corner points mentioned in lines 3, 4 and 5 above were in conformance with the rules of the Michigan Board of Land Surveyors or by a Decree of a Court of Law; established, re-established, monumented, re-monumented, recovered, found as expressed below:


NOTE: Not more than 4 corners, all in the same town and range, may be recorded on this certificate.

1. Description of original monument and accessories and/or subsequent restoration:
 G.L.O., SIBLEY, 1826: W. oak, 14", N26°W, 50 lks; W. oak, 11", S89°E, 50 lks.
 HODGEMAN, 1889: Found stone set many years earlier by Wood & Crawford at location of original stake; also found U.S. bearing tree S24°E, 50 links; placed 1 foot post on top of stone with stones around.
 Witness card from DeKeyser records, no date: Tile, 8 witnesses.
 DAVIS, 1983: found boat spike & set monument 2642.28 feet South of East 1/4 Section 8 and 2645.30 feet West of South 1/4 post of Section 9.

2. Description of corner evidence found and/or method applied in restoring or reestablishing corner:
 Corner is in airport, all witnesses are gone.
 Found 1" pipe with Davis Cap set in concrete; removed pipe and concrete and found 1" bar 3.5' long below Davis monument;
 Dug below 1" bar to depth of 4 to 5 feet and found many stones with magnetic indication in center.
 Excepted location of Davis monument as true perpetuation of corner.

LIBER 1876 PAGE 173

3. Description of monument for corner and accessories established to perpetuate locating the position of the corner:
 Set Berntsen monument at location of Davis monument with Carsonite witness post 0.5 feet North; placed bituminous around monument at surface.
 Center of catch basin, S80°W, 183.00 feet.
 Center of catch basin, S01°W, 156.88 feet.
 East edge of taxiway Northwesterly 358.56 feet.
 North edge of taxiway Southwesterly 673.38 feet.

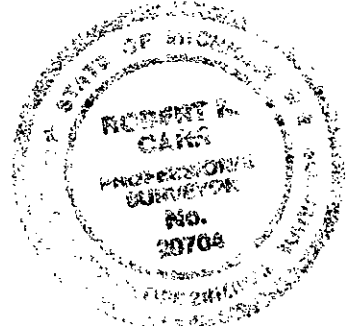

Signed by Robert R. Carr Date July 16, 1996
 Surveyor's Michigan License No. 20704