

FEB 22 1996

COMMISSION

CALHOUN COUNTY REMONUMENTATION
LAND CORNER RECORDATION CERTIFICATE
Filing Requirement of Act 74, Mich. P.A. 1970

APPROVED
Date Sept. 20 1995
CALHOUN COUNTY
REMONUMENTATION.

For corners in

CALHOUN (County)	Located In:	Corner Code #
BATTLE CREEK CITY		
1. Public Land Survey	T 2 S R 8 W	E-6
	T _____ R _____	_____
	T _____ R _____	_____
	T _____ R _____	_____
2. Property Controlling in Section	S _____ T _____ R _____	_____
	S _____ T _____ R _____	_____
3. Miscellaneous Property in Sec.	S _____ T _____ R _____	_____
	S _____ T _____ R _____	_____
4. Lot No. _____, Recorded Plat _____		
5. Private Claims _____		

STATE OF MICHIGAN
CALHOUN COUNTY
RECORDED

22 SEP 95 10:02 A.M.

Register of Deeds Stamp & File Number
CLERK - REGISTER OF DEEDS

	A	B	C	D	E	F	G	H	I	J	K	L	M
2	6		5		4		3		2		1		
3													
4	7		8		9		10		11		12		
5													
6	18		17		16		15		14		13		
7													
8	19		20		21		22		23		24		
9													
10	30		29		28		27		26		25		
11													
12	31		32		33		34		35		36		
13													

I, ROBERT R. CARR, in a field survey on SEPTEMBER 1, 1995, do hereby certify that under requirements of P.A. 74, Michigan P.A. of 1970, the corner points mentioned in lines 1 and 2 above were in conformance with regulations and rules therefore as required in the current manual of survey instructions of the United States Department of the Interior, Bureau of Land Management or by a decree of a Court of Law and/or that the corner points mentioned in lines 3, 4 and 5 above were in conformance with the rules of the Michigan Board of Land Surveyors or by a Decree of a Court of Law; established, re-established, monumented, re-monumented, recovered, found as expressed below:

NOTE: Not more than 4 corners, all in the same town and range, may be recorded on this certificate.

A. Description of original monument and accessories and/or subsequent restoration:

EAST 1/4 POST SECTION 17 TOWN 2 SOUTH RANGE 8 WEST
ORIGINAL CORNER SET BY S. SIBLEY 1826.
F. HODGEMAN 1889 FOUND STONE IN CROSSWAY AND STUMP OF US BEARING TREE, SET TILE OVER STONE.
L.W. CHASE LOCATED CORNER HALF-WAY ON LINE 1957.
L.C.R.C. BY REX MILLIRON MARCH 1988 LIBER 1445 PAGE 34.


3. Description of corner evidence found and/or method applied in restoring or reestablishing corner:

FOUND 1/2" IRON MATCHING WITNESSES OF 1988 L.C.R.C.

LIBER 1822 PAGE 30

2. Description of monument for corner and accessories established to perpetuate locating the position of the corner:

REPLACED 1/2" IRON WITH CALHOUN COUNTY REMONUMENT MONUMENT (BERNTSEN MONUMENT) IN MONUMENT BOX.
NAIL & SPOTTER IN NORTHEAST SIDE OF 40" OAK N46°W 238.54 FEET.
NAIL & SPOTTER IN NORTHEAST SIDE OF U-POLE N68-1/2°W 220.46 FEET.
NAIL & SPOTTER IN SOUTHEAST SIDE OF U-POLE N73°E 356.97 FEET.
NAIL & SPOTTER IN NORTH SIDE OF U-POLE N83°W 32.62 FEET.
NAIL & SPOTTER IN WEST SIDE OF 28" WALNUT S12°E 138.48 FEET.

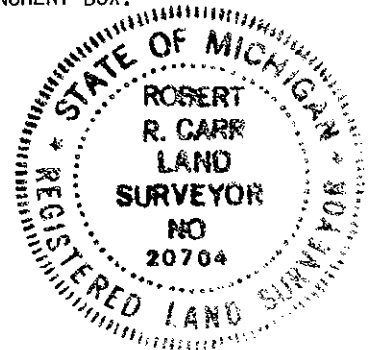

signed by [Signature]
ROBERT R. CARR
Surveyor's Michigan License No. 20704

Date SEPTEMBER 20, 1995