

REMONUMENTATION

FEB 22 1996

COMMISSION

CALHOUN COUNTY REMONUMENTATION

LAND CORNER RECORDATION CERTIFICATE  
Filing Requirement of Act 74, Mich. P.A. 1970

APPROVED  
Date Sept. 22, 1995  
CALHOUN COUNTY  
REMONUMENTATION

For corners in


| CALHOUN<br>(County)                | Located In:               | Corner Code # |
|------------------------------------|---------------------------|---------------|
| Public Land Survey SEC 17          | T <u>2</u> S R <u>8</u> W | E-7           |
|                                    | T _____ R _____           | _____         |
|                                    | T _____ R _____           | _____         |
|                                    | T _____ R _____           | _____         |
| Property Controlling<br>in Section | S _____ T _____ R _____   | _____         |
|                                    | S _____ T _____ R _____   | _____         |
| Miscellaneous<br>Property in Sec.  | S _____ T _____ R _____   | _____         |

STATE OF MICHIGAN  
CALHOUN COUNTY  
RECORDED  
22 SEP 95 10:02 A.M.  
ANNE B. NORLANDER  
Register of Deeds  
CLEAR REGISTER OF DEEDS

Lot No. \_\_\_\_\_, Recorded Plat \_\_\_\_\_  
Private Claims \_\_\_\_\_

ROBERT R. CARR, in a field survey on AUGUST 14, 1995, hereby certify that under requirements of P.A. 74, Michigan P.A. of 1970, the corner points mentioned in lines 1 and 2 above were in conformance with regulations and rules therefore as required in the current manual of survey instructions of the United States Department of the Interior, Bureau of Land Management or by a decree of a Court of Law and/or that the corner points mentioned in lines 3, 4 and 5 above were in conformance with the rules of the Michigan Board of Land Surveyors or by a Decree of a Court of Law; established, re-established, monumented, re-monumented, recovered, found as expressed below:

NOTE: Not more than 4 corners, all in the same town and range, may be recorded on this certificate.

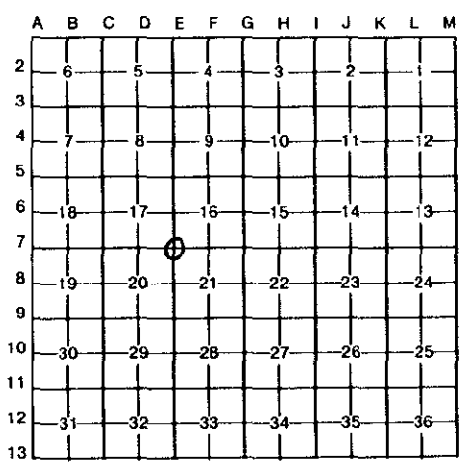

Description of original monument and accessories and/or subsequent restoration:

ORIGINAL CORNER SET BY DEPUTY SURVEYOR SYLVESTER SIBLEY, 1826.  
HODGEMAN, 1887, FOUND OLD LAND SIDE WITH BRICK & STONE AROUND  
FROM REMAINS OF W.O. BEARING TREE AND SET TILE.


Description of corner evidence found and/or method applied in restoring or reestablishing corner:

FOUND TILE WITH OLD LAND SIDE AND BRICKS BESIDE.

LIBER 1822 PAGE 32

Description of monument for corner and accessories established to perpetuate locating the position of the corner:

REPLACED TILE WITH STANDARD CALHOUN REMONUMENTATION CORNER (BERNSTEN MONUMENT) IN MONUMENT BOX.  
NAIL & SPOTTER SOUTH SIDE 14" CHERRY S88°E 25.82 FEET  
NAIL & SPOTTER SOUTHWESTERLY SIDE 18" OAK S29°E 45.90 FEET.  
NAIL & SPOTTER NORTH SIDE 18" WALNUT N62°W 59.48 FEET.  
NAIL & SPOTTER NORTH SIDE U-POLE DUE WEST 25.07 FEET; SOUTHEAST CORNER  
GARAGE N38°W 123.91 FEET.

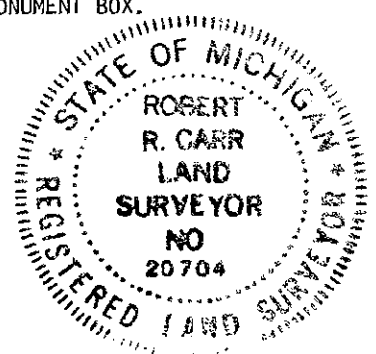

Signed by Robert R. Carr  
Surveyor's Michigan License No. 20704

Date AUGUST 16, 1995