

APPROVED

Date 6-29-94

CALHOUN COUNTY
REMONUMENTATION.

LAND CORNER RECORDATION CERTIFICATE
Filing Requirement of Act 74, Mich. P.A. 1970

For corners in

<u>CALHOUN</u> (County)	Located In:	Corner Code #
1. Public Land Survey	T <u>25</u> R <u>8W</u>	<u>6-12</u>
	T _____ R _____	_____
	T _____ R _____	_____
	T _____ R _____	_____
2. Property Controlling in Section	S _____ T _____ R _____	_____
	S _____ T _____ R _____	_____
3. Miscellaneous Property in Sec.	S _____ T _____ R _____	_____
	S _____ T _____ R _____	_____

STATE OF MICHIGAN
CALHOUN COUNTY
RECORDED

22 JUN 94 1:13 P.M.

ANNE B. NORLANDER
CLERK - REGISTER OF DEEDS
Register of Deeds Stamp & File Number

Bk 3
Page 724

- 4. Lot No. _____, Recorded Plat _____
- 5. Private Claims _____

	A	B	C	D	E	F	G	H	I	J	K	L	M
2	6		5		4		3		2		1		
3													
4	7		8		9		10		11		12		
5													
6	13		17		16		15		14		13		
7													
8	19		20		21		22		23		24		
9													
10	30		29		28		27		26		25		
11													
12	31		32		33		34		35		36		
13													

I, Daniel M. Ryan, in a field survey on January 25, 19 94, do hereby certify that under requirements of P.A. 74, Michigan P.A. of 1970, the corner points mentioned in lines 1 and 2 above were in conformance with regulations and rules therefore as required in the current manual of survey instructions of the United States Department of the Interior, Bureau of Land Management or by a decree of a Court of Law and/or that the corner points mentioned in lines 3, 4 and 5 above were in conformance with the rules of the Michigan Board of Land Surveyors or by a Decree of a Court of Law; established, re-established, monumented, re-monumented, recovered, found as expressed below:

NOTE: Not more than 4 corners, all in the same town and range, may be recorded on this certificate.

A. Description of original monument and accessories and/or subsequent restoration:

RESURVEY - MAY 1887
HODGEMAN
FD GLO STAKE IN WEST
SIDE OF ROAD IN LINE
WITH FENCE EAST.
SET POST.

NOTHING RECORDED

B. Description of corner evidence found and/or method applied in restoring or reestablishing corner:

FD G-13 AS USED FOR PREVIOUS MINGES HILLS PLATS.
1/2" IRON BAR

SURVEY &
REMONUMENTATION

LIBER 1754 PAGE 611

OCT 27 1994

COMMISSION

C. Description of monument for corner and accessories established to perpetuate locating the position of the corner:


REPLACED 1/2" IRON WITH CALHOUN Co. MON.

26" MAPLE S 32°E 48.62 NAIL & SPOTTER

6" ELM N 40°E 30.60 NAIL & SPOTTER

4x4 CONC POST N 30°W 47.20 END NAIL & SPOTTER

38" MAPLE S 20°W 87.90 END NAIL & SPOTTER

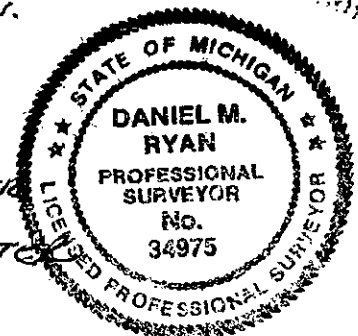

Signed by [Signature]

Date 6-22-94

Surveyor's Michigan License No. 34975