

APPROVED

RECORDED

Date 11-16-93
CALHOUN COUNTY
REMONUMENTATION.

CALHOUN COUNTY REMONUMENTATION
LAND CORNER RECORDATION CERTIFICATE
Filing Requirement of Act 74, Mich. P.A. 1970

NOV 18 2 28 PM '93
CLEAN-REUNITED
CALHOUN COUNTY
MAY 11, 1984

For corners in

<u>Calhoun</u> <small>(County)</small>	Located In:	Corner Code #:
<u>Battle Creek Township</u>		
1. Public Land Survey	T <u>2S</u> R <u>8W</u>	<u>I-9</u>
	T _____ R _____	_____
	T _____ R _____	_____
	T _____ R _____	_____
2. Property Controlling in Section	S _____ T _____ R _____	_____
	S _____ T _____ R _____	_____
3. Miscellaneous Property in Sec.	S _____ T _____ R _____	_____
	S _____ T _____ R _____	_____
4. Lot No. _____, Recorded Plat _____		
5. Private Claims _____		

Book 2 Page 652
Register of Deeds Stamp & File Number

I, Michael A. Groat, in a field survey on November 16, 19 93, do hereby certify that under requirements of P.A. 74, Michigan P.A. of 1970, the corner points mentioned in lines 1 and 2 above were in conformance with regulations and rules therefore as required in the current manual of survey instructions of the United States Department of the Interior, Bureau of Land Management or by a decree of a Court of Law and/or that the corner points mentioned in lines 3, 4 and 5 above were in conformance with the rules of the Michigan Board of Land Surveyors or by a Decree of a Court of Law, established, re-established, monumented, re-monumented, recovered, found as expressed below:

A	B	C	D	E	F	G	H	I	J	K	L	M
2	6	5	4	3	2	1						
3												
4	7	8	9	10	11	12						
5												
6	18	17	16	15	14	13						
7												
8	19	20	21	22	23	24						
9												
10	30	29	28	27	26	25						
11												
12	31	32	33	34	35	36						
13												

NOTE: Not more than 4 corners, all in the same town and range, may be recorded on this certificate.

A. Description of original monument and accessories and/or subsequent restoration:

Resurvey:	1957:	1975 F. Cutcher
Set tile in creek.	Found 2" pipe in tile creek	Bridge Ties
6" Elm S15°W, 4 links	SW corner bridge, N28.6 feet	9" Ash
3" Black Ash, S70°E, 50 links	SE corner bridge, N45°E, 30'	8" Cherry, NE, 25.7 feet
	9" Ash, S45°E, 42.50 feet	LCRC L108, P633.
	9" Twin Elm, S75°E, 31.5 feet	
	"T" Stake, E on line, 10.15 feet	

B. Description of corner evidence found and/or method applied in restoring or reestablishing corner:

Found pipe in creek.
Bridge ties still existing.
9" Ash, S45°E, 42.50 feet (gone).

SURVEY &
REMONUMENTATION


OCT 27 1994

COMMISSION

LIBER 1716 PAGE 453

C. Description of monument for corner and accessories established to perpetuate locating the position of the corner:

Set standard Bernstein monument. Drill hole & stamped 39079.
20' East of corner on North line of the plat of GATES MILLS, Liber 17, page 44, 40' west of the Northeast corner of Lot 16.
SW corner bridge, N10°W, 35.00 feet.
SE corner bridge, N20°W, 26.30 feet.
6" Cherry, S45°E, 4.3 feet
NE corner Lot 16, W40'

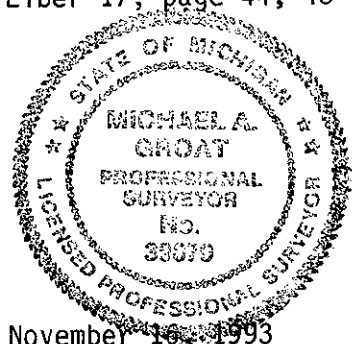

Signed by Michael A. Groat

Date November 16, 1993

Surveyor's Michigan License No. 39079