

**SURVEY &
REMONUMENTATION**

1993

COMMISSION

**CALHOUN COUNTY REMONUMENTATION
LAND CORNER RECORDATION CERTIFICATE
Filing Requirement of Act 74, Mich. P.A. 1970**

RECORDED

Nov 18 2 23 PM '93

CLERK-REGISTER
CALHOUN COUNTY, MICH.
ANNE B. NORLANDER

For corners in

<u>Calhoun</u> (County)	Located In:	Corner Code #/4
<u>Battle Creek Township, Section 27</u>		
1. Public Land Survey	T <u>2S</u> R <u>8W</u>	I-11
	T _____ R _____	_____
	T _____ R _____	_____
	T _____ R _____	_____
2. Property Controlling in Section	S _____ T _____ R _____	_____
	S _____ T _____ R _____	_____
3. Miscellaneous Property in Sec.	S _____ T _____ R _____	_____
	S _____ T _____ R _____	_____
4. Lot No. _____, Recorded Plat _____		
5. Private Claims _____		

Register of Deeds Stamp & File Number

I, Michael A. Groat, in a field survey on November 16, 19 93, do hereby certify that under requirements of P.A. 74, Michigan P.A. of 1970, the corner points mentioned in lines 1 and 2 above were in conformance with regulations and rules therefore as required in the current manual of survey instructions of the United States Department of the Interior, Bureau of Land Management or by a decree of a Court of Law and/or that the corner points mentioned in lines 3, 4 and 5 above were in conformance with the rules of the Michigan Board of Land Surveyors or by a Decree of a Court of Law; established, re-established, monumented, re-monumented, recovered, found as expressed below:

NOTE: Not more than 4 corners, all in the same town and range, may be recorded on this certificate.

	A	B	C	D	E	F	G	H	I	J	K	L	M
2	6	5	4	3	2	1							
3													
4	7	8	9	10	11	12							
5													
6	18	17	16	15	14	13							
7													
8	19	20	21	22	23	24							
9													
10	30	29	28	27	26	25							
11													
12	31	32	33	34	35	36							
13													

A. Description of original monument and accessories and/or subsequent restoration:

Resurvey by Hodgeman:
Found stone set in road
Set tile
12" Hickory, N31½°W, 81 links

1957:
Concrete monument in road
Concrete post, N46°E, 46.30 feet
24" Cherry, S60°W, 52.78 feet


B. Description of corner evidence found and/or method applied in restoring or reestablishing corner:

Found concrete monument in monument box.
No witnesses from 1957.

C. Description of monument for corner and accessories established to perpetuate locating the position of the corner:

Set Bernstein monument in monument box.
12" hickory, S45°W, 65.73 feet. Nail with plastic cap.
U.P. N60°E, 42.24 feet. Nail with plastic cap.
12" Maple, S51°E, 59.16 feet. Nail with plastic cap.
30" Oak, N48°W, 55.33 feet.

LIBER 1716 PAGE 455

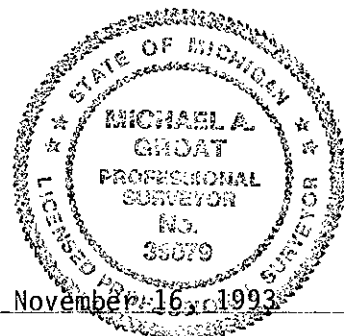

Signed by Michael A. Groat Date November 16, 1993
Surveyor's Michigan License No. 39079