

SURVEY & REMONUMENTATION

1993

COMMISSION

CALHOUN COUNTY REMONUMENTATION LAND CORNER RECORDATION CERTIFICATE Filing Requirement of Act 74, Mich. P.A. 1970

Nov 1 3 58 PM 93

RECORDED

CLERK-REGISTERED CALHOUN COUNTY, MICH. ANNE B. NORLANDER

For corners in

Table with columns: Calhoun (County), Located In: City of Battle Creek, Corner Code: I-13. Rows include Public Land Survey, Property Controlling in Section, and Miscellaneous Property in Sec.

Book 2 Page 685 Register of Deeds Stamp & File Number

4. Lot No. , Recorded Plat
5. Private Claims

Grid table with columns A-M and rows 1-13. A dot is marked in row 11, column J.

I, Daniel M. Ryan, in a field survey on October 18, 1993, do hereby certify that under requirements of P.A. 74, Michigan P.A. of 1970, the corner points mentioned in lines 1 and 2 above were in conformance with regulations and rules therefore as required in the current manual of survey instructions of the United States Department of the Interior, Bureau of Land Management or by a decree of a Court of Law and/or that the corner points mentioned in lines 3, 4 and 5 above were in conformance with the rules of the Michigan Board of Land Surveyors or by a Decree of a Court of Law; established, re-established, monumented, re-monumented, recovered, found as expressed below:

NOTE: Not more than 4 corners, all in the same town and range, may be recorded on this certificate.

A. Description of original monument and accessories and/or subsequent restoration: Resurvey Tile DeKeyser & Associates 69 links West of Leroy Corner Tile with 3/4" iron-3' long WO 12" N27° E, 29 links U-Pole N60°E, 69.50' Cherry 6" S51°W, 7.5 links 3' E of edge of pavement 30" Oak N20°E, 58.10'

Carr & Associates - 9/90 1" iron stake U-Pole N75°E, 39.31' RR tie fence corner N80°W, 13.6 50" Oak N45°E, 55.81' Centerline road East, 14.35' 10" Maple, N55°E, 43.72'


B. Description of corner evidence found and/or method applied in restoring or reestablishing corner:

Found 1" iron stake. Railroad tie Fence corner, N88°W, 14.02 feet, PK in S side. 50" Oak, N45°E, 57.98 feet to 20p nail in S side. Centerline road, East, 14.35 feet. 10" Maple, N47°E, 44.15 feet to 20p nail in N side.

LIBER 1712 PAGE 757

C. Description of monument for corner and accessories established to perpetuate locating the position of the corner:

Set Calhoun County Remonumentation Standard Monument. U-pole, N70°E, 39.82 feet to PK in N side. Railroad tie fence corner, N88°W, 14.02 feet to PK in S side. 50" Oak, N45°E, 57.98 feet to 20p nail in S side. 10" Maple, N47°E, 44.15 feet to 20p nail in N side.

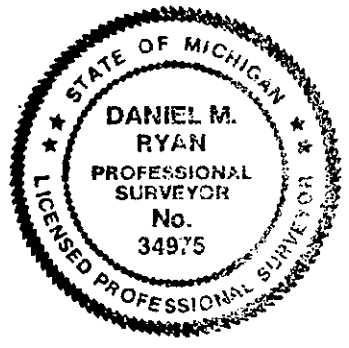

Signed by [Signature] Date October 20, 1993 Surveyor's Michigan License No. 34975