

SURVEY &
REMONUMENTATION

1993

COMMISSION

CALHOUN COUNTY REMONUMENTATION
LAND CORNER RECORDATION CERTIFICATE
Filing Requirement of Act 74, Mich. P.A. 1970

NOV 1 3 58 PM 93

RECORDED

For corners in

Calhoun
(County)

Located In:

Corner Code #

City of Battle Creek

- | | | |
|------------------------------------|-------------------------|------------|
| 1. Public Land Survey | T <u>2S</u> R <u>8W</u> | <u>J-9</u> |
| | T _____ R _____ | _____ |
| | T _____ R _____ | _____ |
| | T _____ R _____ | _____ |
| 2. Property Controlling in Section | S _____ T _____ R _____ | _____ |
| | S _____ T _____ R _____ | _____ |
| 3. Miscellaneous Property in Sec. | S _____ T _____ R _____ | _____ |
| | S _____ T _____ R _____ | _____ |

CLERK-REGISTER
CALHOUN COUNTY, MICH.
ANNE B. M... AIDE

Book 2 Page 634
Register of Deeds Stamp & File Number

4. Lot No. _____, Recorded Plat _____
5. Private Claims _____

	A	B	C	D	E	F	G	H	I	J	K	L	M
2	6	5	4	3	2	1							
3													
4	7	8	9	10	11	12							
5													
6	18	17	16	15	14	13							
7													
8	19	20	21	22	23	24							
9													
10	30	29	28	27	26	25							
11													
12	31	32	33	34	35	36							
13													

I, Daniel M. Ryan, in a field survey on October 18, 19 93, do hereby certify that under requirements of P.A. 74, Michigan P.A. of 1970, the corner points mentioned in lines 1 and 2 above were in conformance with regulations and rules therefore as required in the current manual of survey instructions of the United States Department of the Interior, Bureau of Land Management or by a decree of a Court of Law and/or that the corner points mentioned in lines 3, 4 and 5 above were in conformance with the rules of the Michigan Board of Land Surveyors or by a Decree of a Court of Law; established, re-established, monumented, re-monumented, recovered, found as expressed below:

NOTE: Not more than 4 corners, all in the same town and range, may be recorded on this certificate.


A. Description of original monument and accessories and/or subsequent restoration:
Found Stone with Brick 1971-LCRC L964, P653
 S54°W, 51 links, stump of W.O. Concrete Monument
 N11.5°E, 41 links, 10" Red Oak U-pole, S60°W, 26.80'
 N3.5°E, 85 links, 12" White Oak U-Pole, S80°E, 123.42'
 SW corner Gar. found N30°E, 118.55'
Concrete Monument - 1958
 Set by Clyde Chambers for plat U-pole, 67.57, S48°W, 27.0'
 of MINGES HEIGHTS.

1990 - Carr & Associates
Concrete Monument
Witnesses of U-poles found and gar. found from 1971 also noted

B. Description of corner evidence found and/or method applied in restoring or reestablishing corner:
Found Concrete Monument
 U-pole, 67.57, S35°W, 26.29 feet. Believed to be same as LCRC Witness.

LIBER 1712 PAGE 756

C. Description of monument for corner and accessories established to perpetuate locating the position of the corner:
Set Calhoun County Remonumentation Standard Monument.
 U-pole, 67.57, S35°W, 26.29 feet.
 24" Oak, N50°W, 26.89 feet.
 24" Oak, N4°W, 110.8 feet.
 15" Oak, S20°E, 38.51 feet.

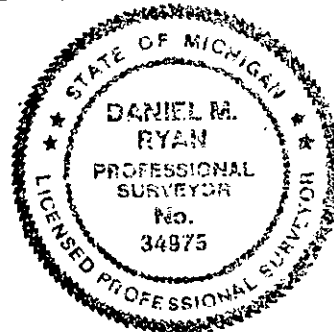

Signed by [Signature] Date October 20, 1993
 Surveyor's Michigan License No. 34975