

OCT 27 1994

CALHOUN COUNTY REMONUMENTATION

COMMISSION

LAND CORNER RECORDATION CERTIFICATE  
Filing Requirement of Act 74, Mich. P.A. 1970

**APPROVED**  
Date 3-16-94  
**CALHOUN COUNTY**  
**REMONUMENTATION.**

For corners in

Calhoun (County)	Located In:	Corner Code #
1. Public Land Survey	T <u>2 S</u> R <u>8 W</u>	<u>K-13</u>
	T _____ R _____	_____
	T _____ R _____	_____
	T _____ R _____	_____
2. Property Controlling in Section	S _____ T _____ R _____	_____
	S _____ T _____ R _____	_____
3. Miscellaneous Property in Sec.	S _____ T _____ R _____	_____
	S _____ T _____ R _____	_____

CLERK-REGISTER  
 CALHOUN COUNTY, MICH.  
 ANNE B. NORLANDER  
 MAR 17 9 57 AM '94

RECORDED

Register of Deeds Stamp & File Number

4. Lot No. \_\_\_\_\_, Recorded Plat \_\_\_\_\_  
5. Private Claims \_\_\_\_\_

	A	B	C	D	E	F	G	H	I	J	K	L	M
2	6		5		4		3		2		1		
3													
4	7		8		9		10		11		12		
5													
6	18		17		16		15		14		13		
7													
8	19		20		21		22		23		24		
9													
10	30		29		28		27		26		25		
11													
12	31		32		33		34		35		36		
13													

I, William K. Crane, in a field survey on March 1, 19 94, do hereby certify that under requirements of P.A. 74, Michigan P.A. of 1970, the corner points mentioned in lines 1 and 2 above were in conformance with regulations and rules therefore as required in the current manual of survey instructions of the United States Department of the Interior, Bureau of Land Management or by a decree of a Court of Law and/or that the corner points mentioned in lines 3, 4 and 5 above were in conformance with the rules of the Michigan Board of Land Surveyors or by a Decree of a Court of Law, established, re-established, monumented, re-monumented, recovered, found as expressed below:

**NOTE: Not more than 4 corners, all in the same town and range, may be recorded on this certificate.**

A. Description of original monument and accessories and/or subsequent restoration:

Original Government Field Notes:	SE Corner-Section 35 Resurvey in 1887 of Battle Creek Township by F. Hodgman:
12" W. Oak N 42° W 56 links	Corner was determined obliterated. Set post 52 links West of the Leroy Corner
6" W. Oak N 45.5° E 134 links	
	10" W. Oak S 67° E 16½ links
	6" Hickory N 45° E 14½ links

B. Description of corner evidence found and/or method applied in restoring or reestablishing corner:


Old witness from Dekeyser & Assoc. Records:	Found ½" reroed believed to have been reset after watermain installation from LCRC recorded May 22, 1972. Book I #51 by Milton Dekeyser:
2" Pipe	2" Pipe
24" Oak South 17.5'	24" Oak South 18.38' (with spotter)
36" Oak East 48.8'	36" Oak East 50.31' (with spotter)
In line with fence East	In line with fence East
	25.0' West of centerline of pavement

This is accepted as a careful and faithful reestablishment of the position of the original corner.

C. Description of monument for corner and accessories established to perpetuate locating the position of the corner:

Replaced ½" reroed with standard Calhoun County Remonumentation Corner (Bernsten Monument):

NE Corner Sec. 2, Leroy Twp.	East	34.32'
Nail & Cap-East side 36" Oak	S 5° E	18.32'
Centerline Fire Hydrant	N 80° E	4.1'
Centerline Water Valve Box	S 45° W	1.1'
North & South Fence	West	8.0'
Centerline Road	East	25.0'
Nail & Cap-East side Utility Pole	N 10° W	93.40'

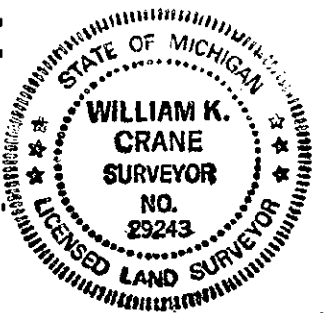

Signed by William K. Crane Date 3/16/94  
Surveyor's Michigan License No. 29243