

**SURVEY &
REMONUMENTATION**

APR 26 1995

APPROVED
Date 11-28-94
**CALHOUN COUNTY
REMONUMENTATION.**

CALHOUN COUNTY REMONUMENTATION

COMMISSION

**LAND CORNER RECORDATION CERTIFICATE
Filing Requirement of Act 74, Mich. P.A. 1970**

For corners in

<u>Calhoun</u> (County)	Located In:	Corner Code =#
1. Public Land Survey	T <u>2</u> S R <u>8</u> W	<u>L-9</u>
	T _____ R _____	_____
	T _____ R _____	_____
	T _____ R _____	_____
2. Property Controlling in Section	S _____ T _____ R _____	_____
	S _____ T _____ R _____	_____
3. Miscellaneous Property in Sec.	S _____ T _____ R _____	_____
	S _____ T _____ R _____	_____
4. Lot No. _____, Recorded Plat _____		
5. Private Claims _____		

STATE OF MICHIGAN
CALHOUN COUNTY
RECORDED

29 NOV 94 10:24 A.M.

ANNE B. NORLANDER
CLERK - REGISTER OF DEEDS

Register of Deeds Stamp & File Number

I, William K. Crane, in a field survey on November 6, 1994, do hereby certify that under requirements of P.A. 74, Michigan P.A. of 1970, the corner points mentioned in lines 1 and 2 above were in conformance with regulations and rules therefore as required in the current manual of survey instructions of the United States Department of the Interior, Bureau of Land Management or by a decree of a Court of Law and/or that the corner points mentioned in lines 3, 4 and 5 above were in conformance with the rules of the Michigan Board of Land Surveyors or by a Decree of a Court of Law; established, re-established, monumented, re-monumented, recovered, found as expressed below:

NOTE: Not more than 4 corners, all in the same town and range, may be recorded on this certificate.

A. Description of original monument and accessories and/or subsequent restoration:
Original Government Field Note (1826 by Sylvester Sibley):
12" Bl. Oak S44 E 103 Links
9" W. Oak N 44 W 107 Links

A	B	C	D	E	F	G	H	I	J	K	L	M
2	6	5	4	3	2	1						
3												
4	7	8	9	10	11	12						
5												
6	18	17	16	15	14	13						
7												
8	19	20	21	22	23	24						
9												
10	30	29	28	27	26	25						
11												
12	31	32	33	34	35	36						
13												

Resurvey in 1887 of Battle Creek Township by F. Hodgman: Found stake with brick around in line with fence East and West. Set post:
18" Y Oak N 77 W 54 Links
8" Y Oak N 88 E 57 1/2 Links


B. Description of corner evidence found and/or method applied in restoring or reestablishing corner:
Tile was found in 1953 by L.W. Chase he set "T" iron over tile and took the witnesses listed below. Found 1/2" rerod which measured good to the three utility poles listed below. Excavated to a depth of 3 1/2 feet and found no other evidence of corner.

- E. Cor. Stone House SW 152.80'
- E. Cor. Brick House NW 150.80'
- E. Cor. Brick Gar. NW 158.25'
- U. Pole East 32.57'
- U. Pole S40E 108.98'
- U. Pole S25W 52.30'

LIBER 1778 PAGE 571

C. This is accepted as a careful and faithful perpetuation of the position of the original corner.
Description of monument for corner and accessories established to perpetuate locating the position of the corner:
Replaced 1/2 rerod with Standard Calhoun County remonumentation corner (Berntsen Monument) in monument box:

- U. Pole East 32.60'
- U. Pole S40E 108.83'
- U. Pole S25W 52.29'
- Top of Fire Hydrant N80W 38.35'

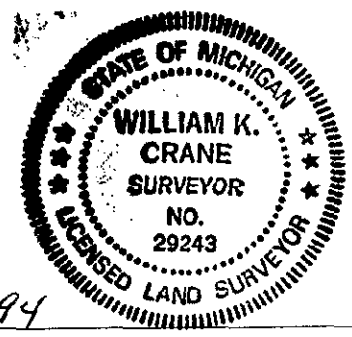

Signed by William K Crane

Date 11/22/94

Surveyor's Michigan License No. 29243