

SURVEY &  
REMONUMENTATION

APR 26 1995

APPROVED

Date 11-28-94  
CALHOUN COUNTY  
REMONUMENTATION.

Calhoun County Remonumentation

LAND CORNER RECORDATION CERTIFICATE  
Filing Requirement of Act 74, Mich. P.A. 1970

COMMISSION

For corners in

Calhoun (County)	Located in:	Corner Code #
1. Public Land Survey	T <u>2</u> S R <u>8</u> W	<u>L - 11</u>
	T _____ R _____	_____
	T _____ R _____	_____
	T _____ R _____	_____
2. Property Controlling in Section	S _____ T _____ R _____	_____
	S _____ T _____ R _____	_____
3. Miscellaneous Property in Sec.	S _____ T _____ R _____	_____
	S _____ T _____ R _____	_____

STATE OF MICHIGAN  
CALHOUN COUNTY  
RECORDED

29 NOV 94 10:24 A.M.

ANNE B. NORLANDER  
CLERK - REGISTER OF DEEDS

Register of Deeds Stamp & File Number

4. Lot No. \_\_\_\_\_, Recorded Plat \_\_\_\_\_  
5. Private Claims \_\_\_\_\_

	A	B	C	D	E	F	G	H	I	J	K	L	M
2	6	5	4	3	2	1							
3													
4	7	8	9	10	11	12							
5													
6	18	17	16	15	14	13							
7													
8	19	20	21	22	23	24							
9													
10	30	29	28	27	26	25							
11													
12	31	32	33	34	35	36							
13													

I, William K. Crane, in a field survey on November 6, 19 94, do hereby certify that under requirements of P.A. 74, Michigan P.A. of 1970, the corner points mentioned in lines 1 and 2 above were in conformance with regulations and rules therefore as required in the current manual of survey instructions of the United States Department of the Interior, Bureau of Land Management or by a decree of a Court of Law and/or that the corner points mentioned in lines 3, 4 and 5 above were in conformance with the rules of the Michigan Board of Land Surveyors or by a Decree of a Court of Law; established, re-established, monumented, re-monumented, recovered, found as expressed below:

NOTE: Not more than 4 corners, all in the same town and range, may be recorded on this certificate.

A. Description of original monument and accessories and/or subsequent restoration:  
Original Government Field Notes (1826 by Sylvester Sibley):

38" W Oak N 21 E 56 Links  
20" W Oak S 82 E 26 Links

Resurvey in 1887 of Battle Creek Township by F. Hodgman:  
Found old stake with stone beside at intersection of road lines and in line with fence South. Set Post  
8" Elm N 32 1/2 W 73 1/2 Links

B. Description of corner evidence found and/or method applied in restoring or reestablishing corner:


L.W. Chase 1961: LCRC Book 2 Page 373  
1/2" Solid iron rod 1977 Robert R. Carr  
Cor FC Post N 50° W 43.82' 1/2" Solid Iron  
14" Walnut S 34 E 27.38' 16" Walnut S 34 E  
22" Walnut S 44 W 38.33" 22" Walnut S 44 W  
32" Elm NW 64.32 SE COR Headwall N 5 E 131.58  
U. Pole S 30 W 69.11  
G. Pole S 60 71.91

LCRC Book 2 Page 499 Found P.K. nail.  
1984 Edward R. Enz No witnesses remain  
Found 3/8" rerod in Mon Box following road construction. Excavated and found bent rerod below new asphalt.  
N 50 E 83.94' 5" Pine  
N 45 W 92.22' U. Pole  
S 5 W 59.78' U. Pole  
S 60 E 98.78' HYD.

This is accepted as a careful and faithful reestablishment of the position of the original corner. LIBER 1778 PAGE 572

C. Description of monument for corner and accessories established to perpetuate locating the position of the corner:  
Replaced P.K. nail and 1/2" rerod with Standard Calhoun County Remonumentation corner (Bernsten Monument) in monument box

U. Pole N 45 W 94.80'  
U. Pole N 45 E 68.80'  
U. Pole S 55 E 116.15'  
U. Pole S 55 W 80.75'

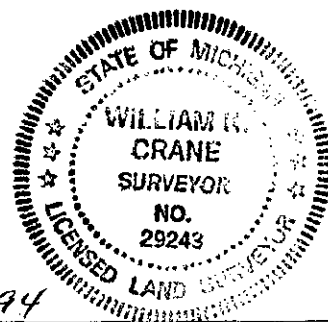

Signed by William K. Crane  
Surveyor's Michigan License No. 29243

Date 11/22/94