

APPROVED
 Date SEPT 18 1996
CALHOUN COUNTY
REMONUMENTATION.

CALHOUN COUNTY REMONUMENTATION
LAND CORNER RECORDATION CERTIFICATE
Filing Requirement of Act 74, Mich. P.A. 1970

SURVEY & REMONUMENTATION
MAR 21 1997
COMMISSION

For corners in

<u>CALHOUN</u> <small>(County)</small>	Located In:	Corner Code #
City of Battle Creek (old Battle Creek Twp)		
1. Public Land Survey	T <u>2</u> S R <u>8</u> W	<u>M-7</u>
	T _____ R _____	_____
	T _____ R _____	_____
	T _____ R _____	_____
2. Property Controlling in Section	S _____ T _____ R _____	_____
	S _____ T _____ R _____	_____
3. Miscellaneous Property in Sec.	S _____ T _____ R _____	_____
	S _____ T _____ R _____	_____
4. Lot No. _____, Recorded Plat _____		
5. Private Claims _____		

STATE OF MICHIGAN
 CALHOUN COUNTY
 RECORDED
 24 SEP 96 10:59 A.M.
 ANNE B. NORLANDER
 CLERK - REGISTER OF DEEDS
 Register of Deeds Stamp & File Number

City of Battle Creek
(old Battle Creek Twp)

	A	B	C	D	E	F	G	H	I	J	K	L	M
2	6	5	4	3	2	1							
3													
4	7	8	9	10	11	12							
5													
6	18	17	16	15	14	13							
7													
8	19	20	21	22	23	24							
9													
10	30	29	28	27	26	25							
11													
12	31	32	33	34	35	36							
13													

I, ROBERT R. CARR in a field survey on SEPT. 17, 19 96, do hereby certify that under requirements of P.A. 74, Michigan P.A. of 1970, the corner points mentioned in lines 1 and 2 above were in conformance with regulations and rules therefore as required in the current manual of survey instructions of the United States Department of the Interior, Bureau of Land Management or by a decree of a Court of Law and/or that the corner points mentioned in lines 3, 4 and 5 above were in conformance with the rules of the Michigan Board of Land Surveyors or by a Decree of a Court of Law; established, re-established, monumented, re-monumented, recovered, found as expressed below:


NOTE: Not more than 4 corners, all in the same town and range, may be recorded on this certificate.

A. Description of original monument and accessories and/or subsequent restoration:
 G.L.O.; ORIGINAL CORNER SET BY S. SIBLEY D.S., 1826.
 RESURVEY; F. HODGEMAN FOUND STAKE AND ONE G.L.O. WITNESS, SET POST (TILE).
 M.D.O.T. FOUND TILE, 30" OAK S85°W, 13.34 FT; 18" OAK N5°E 42.91 FT.;
 6" OAK N85°3 23.84 FEET, 1956.
 PLAT OF "CHAPEL HILL ESTATES", LIBER 13, PAGE 12.

B. Description of corner evidence found and/or method applied in restoring or reestablishing corner:
 FOUND CONCRETE MONUMENT AT NE CORNER OF PLAT OF "CHAPEL HILL ESTATES", LIBER 13, PAGE 12, MATCHING TWO OF M.D.O.T. WITNESSES TO TILE.
 ACCEPTED CONCRETE MONUMENT AS TRUE PERPETUATION OF CORNER.

LIBER 1887 PAGE 978

C. Description of monument for corner and accessories established to perpetuate locating the position of the corner:
 REPLACED CONCRETE WITH CALHOUN COUNTY REMON (BERNTSEN MONUMENT) WITH CARSONITE WITNESS POST BESIDE.
 NAIL & SPOTTER IN EASTERLY SIDE OF 24" OAK, N07°E, 42.98 FEET.
 NAIL & SPOTTER IN SOUTHERLY SIDE OF 16" OAK N82°E 24.00 FEET.
 NAIL & SPOTTER IN NORTHERLY SIDE OF 75" OAK S75°W 13.12 FEET.
 NAIL & SPOTTER IN WESTERLY SIDE OF 6" OAK S14°E 33.29 FEET.
 TILE AT SE CORNER SECTION 18, T2S, R7W, SOUTH 45.60 FEET.
 IN HIGHWAY M-66 RIGHT-OF-WAY FENCE.
 FACE OF GAS PIPELINE MARKER S14°W 26.60 FEET.

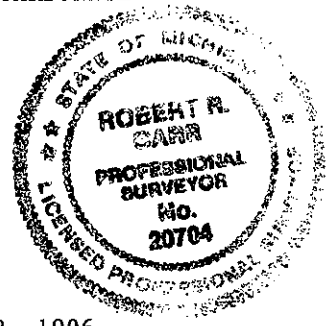

Signed by Robert R. Carr
 Surveyor's Michigan License No. 20704

Date SEPTEMBER 18, 1996