

**SURVEY & REMONUMENTATION**

MAR 21 1997

**COMMISSION**

STATE OF MICHIGAN  
CALHOUN COUNTY  
RECORDED

24 SEP 96 10:59 A.M.

ANNE B. NORLANDER  
CLERK - REGISTER OF DEEDS

Register of Deeds Stamp & File Number

**APPROVED**

Date SEPT 18 1996  
**CALHOUN COUNTY  
REMONUMENTATION.**

CALHOUN COUNTY REMONUMENTATION

**LAND CORNER RECORDATION CERTIFICATE**  
Filing Requirement of Act 74, Mich. P.A. 1970

For corners in

CALHOUN (County)	Located In:	Corner Code #
CITY OF BATTLE CREEK (Old Battle Creek Twp)	T <u>2</u> S R <u>8</u> W	M-8
1. Public Land Survey	T _____ R _____	_____
	T _____ R _____	_____
	T _____ R _____	_____
2. Property Controlling in Section	S _____ T _____ R _____	_____
	S _____ T _____ R _____	_____
3. Miscellaneous Property in Sec.	S _____ T _____ R _____	_____

4. Lot No. \_\_\_\_\_, Recorded Plat \_\_\_\_\_  
5. Private Claims \_\_\_\_\_

CITY OF BATTLE CREEK  
(OLD BATTLE CREEK TWP)

	A	B	C	D	E	F	G	H	I	J	K	L	M
2	6	5	4	3	2	1							
3													
4	7	8	9	10	11	12							
5													
6	18	17	16	15	14	13							
7													
8	19	20	21	22	23	24							
9													
10	30	29	28	27	26	25							
11													
12	31	32	33	34	35	36							
13													

I, ROBERT R. CARR, in a field survey on SEPTEMBER 17, 1996, do hereby certify that under requirements of P.A. 74, Michigan P.A. of 1970, the corner points mentioned in lines 1 and 2 above were in conformance with regulations and rules therefore as required in the current manual of survey instructions of the United States Department of the Interior, Bureau of Land Management or by a decree of a Court of Law and/or that the corner points mentioned in lines 3, 4 and 5 above were in conformance with the rules of the Michigan Board of Land Surveyors or by a Decree of a Court of Law: established, re-established, monumented, re-monumented, recovered, found as expressed below:

**NOTE: Not more than 4 corners, all in the same town and range, may be recorded on this certificate.**

A. Description of original monument and accessories and/or subsequent restoration:

G.L.O.; ORIGINAL CORNER SET BY S. SIBLEY D.S., 1826  
RESURVEY; F. HODGMAN, 1889, FOUND OLD STAKE AT 1.5 FT BELOW SURFACE AT INTERSECTION OF FENCES WEST & SOUTH AND SET POST (TILE).  
PLAT OF "SOUTHGATE NO. 1", LIBER 16, PAGE 21 (CORNER IS SE CORNER OF PLAT).  
PLAT OF "COUNTRY CLUB TERRACE" LIBER 12, PAGE 04 (CORNER IS NE CORNER OF PLAT).


B. Description of corner evidence found and/or method applied in restoring or reestablishing corner:

FOUND CONCRETE MONUMENT COMMON TO SE CORNER OF PLAT OF "SOUTHGATE NO. 1" AND NE CORNER OF PLAT OF "COUNTRY CLUB TERRACE".  
FINDING NO CONFLICTING EVIDENCE ACCEPTED CONCRETE MONUMENT AS TRUE PERPETUATION OF CORNER.

LIBER 1887 PAGE 977

C. Description of monument for corner and accessories established to perpetuate locating the position of the corner:

REPLACE CONCRETE MONUMENT WITH CALHOUN COUNTY (BERNTSEN MONUMENT) WITH CARSONITE WITNESS POST BESIDE.  
NAIL & SPOTTER IN NORTHERLY SIDE OF 14" OAK N73°W 22.46 FEET.  
NAIL & SPOTTER IN EASTERLY SIDE OF 28" OAK N02°E 36.82 FEET.  
NAIL & SPOTTER IN WESTERLY SIDE OF 14" CHERRY S15°W 24.48 FEET.  
NAIL & SPOTTER IN WESTERLY SIDE OF 14" CHERRY S28°E 19.41 FEET.  
NW CORNER OF HEADWALL TO CULVERT UNDER HIGHWAY M-66 S54°E 52.88 FEET.  
IN HIGHWAY RIGHT-OF-WAY FENCE.

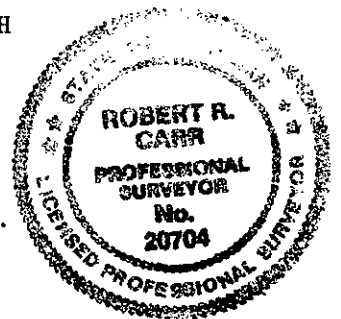

Signed by Robert R. Carr Date SEPTEMBER 18, 1996  
Surveyor's Michigan License No. 20704