

1993

COMMISSION

LAND CORNER RECORDATION CERTIFICATE  
Filing Requirement of Act 74, Mich. P.A. 1970

Oct. 6 9 46 AM 93

CLERK-REGISTER  
CALHOUN COUNTY, MICH.  
ANNE B. NORTANDER

For corners in

Calhoun  
(County)

Located In:

Corner Code ##

- |                                    |                         |           |
|------------------------------------|-------------------------|-----------|
| 1. Public Land Survey              | T <u>2S</u> R <u>8W</u> | <u>M9</u> |
|                                    | T _____ R _____         | _____     |
|                                    | T _____ R _____         | _____     |
|                                    | T _____ R _____         | _____     |
| 2. Property Controlling in Section | S _____ T _____ R _____ | _____     |
|                                    | S _____ T _____ R _____ | _____     |
| 3. Miscellaneous Property in Sec.  | S _____ T _____ R _____ | _____     |
|                                    | S _____ T _____ R _____ | _____     |
4. Lot No. \_\_\_\_\_, Recorded Plat \_\_\_\_\_
5. Private Claims \_\_\_\_\_

Register of Deeds Stamp & File Number

I, William K Crane, in a field survey on May 28, 19 93, do hereby certify that under requirements of P.A. 74, Michigan P.A. of 1970, the corner points mentioned in lines 1 and 2 above were in conformance with regulations and rules therefore as required in the current manual of survey instructions of the United States Department of the Interior, Bureau of Land Management or by a decree of a Court of Law and/or that the corner points mentioned in lines 3, 4 and 5 above were in conformance with the rules of the Michigan Board of Land Surveyors or by a Decree of a Court of Law; established, re-established, monumented, re-monumented, recovered, found as expressed below:

NOTE: Not more than 4 corners, all in the same town and range, may be recorded on this certificate.

A	B	C	D	E	F	G	H	I	J	K	L	M
2	6	5	4	3	2	1						
3												
4	7	6	9	10	11	12						
5												
6	18	17	16	15	14	13						
7												
8	19	20	21	22	23	24						
9												
10	30	29	28	27	26	25						
11												
12	31	32	33	34	35	36						
13												

A. Description of original monument and accessories and/or subsequent restoration:

Original Government Field Notes:

Resurvey in 1887 of Battle Creek Township by F. Hodgman:

9" w. oak N40°W 40 links  
6" y. oak S49°W 43 links

Found old stake hole with rotten stake at intersection of fence lines west and south

14" w. oak N33°E 44 links  
18" r. oak S88°E 25½ links

B. Description of corner evidence found and/or method applied in restoring or reestablishing corner:

Found clay tile from resurvey and the following reference ties from 1976 MDOT records:

19" oak S70°E 10.97  
12" oak N60°E 9.14  
16" oak North 16.61  
R.O.W. fence East 4.4  
Secor shed N50°W 10.09


LIBER 1707 PAGE 269

This is accepted as a careful and faithful perpetuation of the position of the original corner.

C. Description of monument for corner and accessories established to perpetuate locating the position of the corner:

Replaced tile with standard Calhoun County remonumentation corner (Berntsen Monument)

SE cor. garage foundation	N50°W	19.10
Fd. nail & MSHD ref. tag in 12" oak	N60°E	9.18
Set nail 24" oak	S70°E	11.05
Fd. nail & MSHD ref. tag in 18" oak	North	16.63

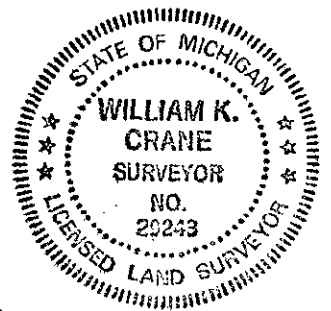

Signed by William K Crane

Date 9/17/93

Surveyor's Michigan License No. 29243