

1993

COMMISSION

CALHOUN COUNTY REMONUMENTATION LAND CORNER RECORDATION CERTIFICATE

Oct 6 9 46 AM '93

CLERK-REGISTER CALHOUN COUNTY, MICH. ANNE B. NORLANDER

For corners in

Table with columns: Calhoun (County), Located In, Corner Code #. Rows include Public Land Survey, Property Controlling in Section, and Miscellaneous Property in Sec.

Register of Deeds Stamp & File Number

4. Lot No. , Recorded Plat
5. Private Claims

Grid table with columns A-M and rows 2-13, containing numbers 1-36.

I, William K. Crane in a field survey on September 13, 1993, do hereby certify that under requirements of P.A. 74, Michigan P.A. of 1970, the corner points mentioned in lines 1 and 2 above were in conformance with regulations and rules therefore as required in the current manual of survey instructions of the United States Department of the Interior, Bureau of Land Management or by a decree of a Court of Law and/or that the corner points mentioned in lines 3, 4 and 5 above were in conformance with the rules of the Michigan Board of Land Surveyors or by a Decree of a Court of Law; established, re-established, monumented, re-monumented, recovered, found as expressed below:

NOTE: Not more than 4 corners, all in the same town and range, may be recorded on this certificate.


A. Description of original monument and accessories and/or subsequent restoration: Original Government Field Notes: Resurvey in 1887 of Battle Creek Township by F. Hodgmen: 9" Aspen S43W 150 Links 6" Double Oak N2 1/2 W 156 Links Set post in Marsh S21/28E 156 links from double white oak U.S. bearing tree

B. Description of corner evidence found and/or method applied in restoring or reestablishing corner: Found 3/4" diameter pipe as recorded by MDOT in L. 1098 P. 835. Corner destroyed by I-94 & M-66 construction. It was re-established from ties on Highway plans, Project 13-70, file #13-R-2, sheet #21 and U-43-1 sheet #14. FD 3/4" iron pipe and the following reference ties: N 16°W 54.10 3" locust N45°E 13.47 2" crab apple S85°E 50.73 NW cor. bridge pier South 19.58 W1/4 Cor Sec 30, T25, R7W (3/4" pipe) This is accepted as a careful and faithful perpetuation of the position of the original corner.

LIBER 1707 PAGE 270

C. Description of monument for corner and accessories established to perpetuate locating the position of the corner: Replaced 3/4" iron with standard Calhoun County Remonumentation Corner (Berntsen Monument)

Table with columns: Description, Bearing, Distance. Rows include Set Nail E. side 6" locust, FD nail W. Side 3" crab apple, NW Cor Bridge Pier, W 1/4 Cor Sec. 30, T25, R7W (3/4" pipe)

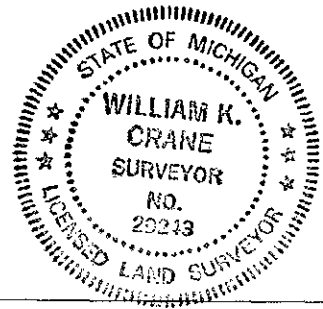

Signed by William K Crane Date 9/17/93

Surveyor's Michigan License No. 29243