

OCT 27 1994

COMMISSION STATE OF MICHIGAN CALHOUN COUNTY RECORDED

25 APR 94 12:14 P.M.

ANNE B. NORLANDER CLERK - REGISTER OF DEEDS

Register of Deeds Stamp & File Number

APPROVED

Date 4-20-94 CALHOUN COUNTY REMONUMENTATION.

CALHOUN COUNTY REMONUMENTATION LAND CORNER RECORDATION CERTIFICATE Filing Requirement of Act 74, Mich. P.A. 1970

For corners in

Table with columns: Calhoun (County), Located In:, Corner Code #/

- 4. Lot No. , Recorded Plat
5. Private Claims

William K. Crane in a field survey on April 4, 1994 do hereby certify that under requirements of P.A. 74, Michigan P.A. of 1970, the corner points mentioned in lines 1 and 2 above were in conformance with regulations and rules therefore as required in the current manual of survey instructions of the United States Department of the Interior, Bureau of Land Management or by a decree of a Court of Law and/or that the corner points mentioned in lines 3, 4 and 5 above were in conformance with the rules of the Michigan Board of Land Surveyors or by a Decree of a Court of Law; established, re-established, monumented, re-monumented, recovered, found as expressed below:

NOTE: Not more than 4 corners, all in the same town and range, may be recorded on this certificate.

Grid table with columns A-M and rows 2-13

A. Description of original monument and accessories and/or subsequent restoration:

Original Government Field Notes:

9" W. Oak S 70° W 49 links
6" W. Oak N 43 1/2° W 15 links

Resurvey in 1887 of Battle Creek Township by F. Hodgman:

He determined corner was lost. From East 1/4 post, Section 25, ran South on random line 80.51 chains to East 1/4 post, Section 36. North corrected line 40.25 1/2. Set post for corners of Section 25 & 36. 20" W. Ash N 48-3/4° W 48 links 16" Hickory N 40° E 49 links

B. Description of corner evidence found and/or method applied in restoring or reestablishing corner:

Found boatspike in Monument Box as recorded in LCRC in L. 1098, P. 834.

Removed boatspike and found pieces of clay tile from the 1887 resurvey below. L. W. Chase found the tile in 1961, 4.62 feet North of Emmett corner.


This is accepted as a careful and faithful reestablishment of the position of the original corner.

LIBER 1743 PAGE 582

C. Description of monument for corner and accessories established to perpetuate localing the position of the corner:

Replaced boatspike with standard Calhoun County Remonumentation Corner (Bernsten Monument) in Monument Box.

Table with columns: Monument description, Bearing, Distance

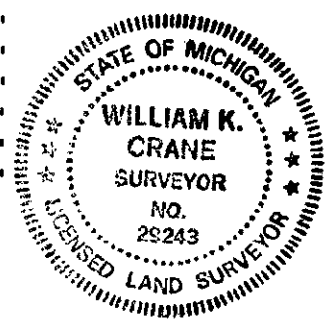

Signed by William K Crane Date 4/20/94

Surveyor's Michigan License No. 29243