

OCT 24 1994

APPROVED
Date 8-17-94
CALHOUN COUNTY
REMONUMENTATION.

COMMISSION
CALHOUN COUNTY REMONUMENTATION
LAND CORNER RECORDATION CERTIFICATE
Filing Requirement of Act 74, Mich. P.A. 1970

OCT 27 1994
STATE OF MICHIGAN
CALHOUN COUNTY
RECORDED

For corners in

18 AUG 94 12:10 P.M.

Calhoun (County)	Located In:	Corner Code #
1. Public Land Survey	T <u>2</u> S. R <u>8</u> W.	<u>M-12</u>
	T _____ R _____	_____
	T _____ R _____	_____
	T _____ R _____	_____
2. Property Controlling in Section	S _____ T _____ R _____	_____
	S _____ T _____ R _____	_____
3. Miscellaneous Property in Sec.	S _____ T _____ R _____	_____
	S _____ T _____ R _____	_____
4. Lot No. _____, Recorded Plat _____		
5. Private Claims _____		

ANNE B. NORLANDER
CLERK - REGISTER OF DEEDS

Register of Deeds Stamp & File Number

I, William K. Crane, in a field survey on August 8, 19 94, do hereby certify that under requirements of P.A. 74, Michigan P.A. of 1970, the corner points mentioned in lines 1 and 2 above were in conformance with regulations and rules therefore as required in the current manual of survey instructions of the United States Department of the Interior, Bureau of Land Management or by a decree of a Court of Law and/or that the corner points mentioned in lines 3, 4 and 5 above were in conformance with the rules of the Michigan Board of Land Surveyors or by a Decree of a Court of Law; established, re-established, monumented, re-monumented, recovered, found as expressed below:

	A	B	C	D	E	F	G	H	I	J	K	L	M
2	6		5		4		3		2		1		
3													
4	7		8		9		10		11		12		
5													
6	18		17		16		15		14		13		
7													
8	19		20		21		22		23		24		
9													
10	30		29		28		27		26		25		
11													
12	31		32		33		34		35		36		
13													

NOTE: Not more than 4 corners, all in the same town and range, may be recorded on this certificate.

A. Description of original monument and accessories and/or subsequent restoration:

E 1/4 Corner - Section 36

Original Government Field Notes:

Resurvey of Battle Creek Township in 1887 by F. Hodgman:

7" W. Oak N 5.5° W 30 links
6" W. Oak S 7° W 24 links

Found stone with brick set for corner and put 1 foot post on top of stone.

10" Sassafras N 27.5° W 86 links
12" Maple S 79° E 55.5 links

B. Description of corner evidence found and/or method applied in restoring or reestablishing corner:

Records of Dekeyser & Associates indicate a concrete monument with the following witnesses:

1973 Dekeyser & Associates witnesses by C. Pike:

30" Maple S 79° E 55.5 links (resurvey witness)
18" Hickory East 87.0'
18" Hickory NNW 78.7'
14" Walnut WSW 32.5'

Concrete Monument:

5" Hickory N 65° W 40.9'
16" Maple S 45° E 65.4'
10" Walnut S 35° W 73.3'
In line with fence East and West and slightly West of centerline of road.

In line with fence East and West and slightly West of centerline of road.


Found 1/2" rerod 1.5' West of centerline of 6 Mile Road in line with fence to East. Excavated and found another 1/2" rerod below. Excavated and found hexagon shaped concrete monument.

C. Description of monument for corner and accessories established to perpetuate locating the position of the corner:

Replace irons and concrete monuments with standard Calhoun County Remonumentation corner. (Bernsten Monument)

24" Maple S 50° E
12" Walnut S 15° W
12" Walnut West
24" Hickory N 20° E
(all trees have nails & CCR spotters)

65.8'
72.9'
51.3'
90.5'

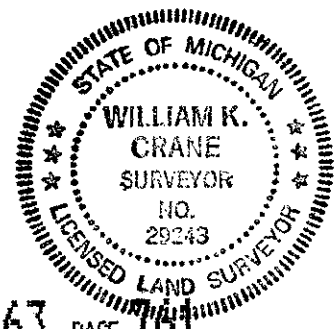

Signed by William K Crane

Date 8/16/94 LIBER 1763 PAGE 761

Surveyor's Michigan License No. 29243

1763 Pg 761