

1993 COMMISSION

CALHOUN COUNTY REMONUMENTATION

LAND CORNER RECORDATION CERTIFICATE
Filing Requirement of Act 74, Mich. P.A. 1970


Nov 19 12 59 PM 93

CLERK-REGISTER
CALHOUN COUNTY, MICH.
ANNE B. NORLANDER

For corners in

Form with fields for County (Calhoun), Located In, Corner Code, and numbered items 1-5 describing survey details.

Register of Deeds Stamp & File Number

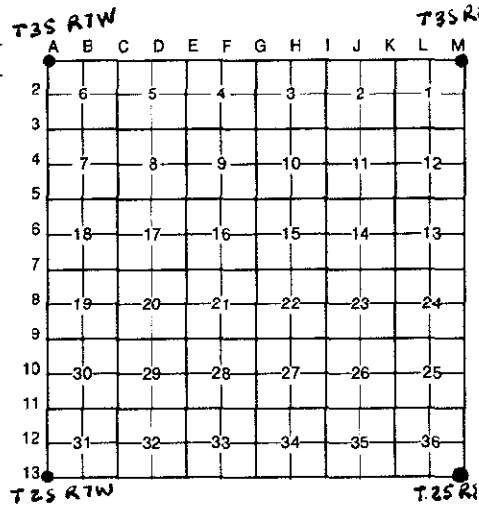

I, Wm. K. Crane, in a field survey on November 8, 19 93, do hereby certify that under requirements of P.A. 74, Michigan P.A. of 1970, the corner points mentioned in lines 1 and 2 above were in conformance with regulations and rules therefore as required in the current manual of survey instructions of the United States Department of the Interior, Bureau of Land Management or by a decree of a Court of Law and/or that the corner points mentioned in lines 3, 4 and 5 above were in conformance with the rules of the Michigan Board of Land Surveyors or by a Decree of a Court of Law; established, re-established, monumented, re-monumented, recovered, found as expressed below:

NOTE: Not more than 4 corners, all in the same town and range, may be recorded on this certificate.

A. Description of original monument and accessories and/or subsequent restoration:

Original Government Field Notes (John Mullett 1825)

Resurvey in 1887 of Battle Creek Twp by F. Hodgman:

9" Y. Oak N82E 435 Links
10" W. Oak S32E 192 Links

Found stake standing in marsh N32W 192 links from dead W. Oak bearing tree set post and marked 16" W. Oak S12E 217 links

Township corner common to Battle Creek, Emmett, Leroy and Newton.

B. Description of corner evidence found and/or method applied in restoring or reestablishing corner:

Found capped iron in marsh as recorded by Milton Dekeyser on Sept. 20, 1972, in L.1032, P. 610. At that time they found pieces of tile set in 1887 with stone piled around it. All witness trees were dead. Found remains of corner fence post and stone pile.

4" Maple S55W 13.30'
4" Maple S45E 24.30'
10" Poplar N45W 26.75'
Corner Fence Post with stones around WEST 28.50'


LIBER 1716 PAGE 616

This is accepted as a careful and faithful perpetuation of the position of the original corner.

C. Description of monument for corner and accessories established to perpetuate locating the position of the corner:

Set standard Calhoun County Remonumentation Corner (Berntsen Monument) over capped iron.

Nail S. Side 12" Maple S85E 41.05'
Nail SW Side 24" Poplar S40E 32.30'
Nail W Side 12" Maple S15E 51.95'
Nail N Side 26" Poplar S70W 30.00'
Remains of fence post in stone pile WEST 28.50'

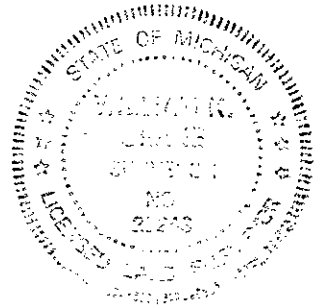

Signed by William K Crane

Date 11/17/93

Surveyor's Michigan License No. 29243