

APPROVED

Date 11-12-96

CALHOUN COUNTY REMONUMENTATION.

CALHOUN COUNTY REMONUMENTATION LAND CORNER RECORDATION CERTIFICATE Filing Requirement of Act 74, Mich. P.A. 1970

STATE OF MICHIGAN CALHOUN COUNTY RECORDED

19 NOV 96 2:00 P.M.

ANNE B. NORLANDER CLERK - REGISTER OF DEEDS


LIBER 1899 PAGE 616

Register of Deeds Stamp & File Number

Table with columns: Calhoun (County), Albion Twp., Located In, Corner Code #. Includes entries for Public Land Survey and Property Controlling in Section.

4. Lot No. _____, Recorded Plat _____
5. Private Claims _____

Frederick J. Cutcher, in a field survey on October 25, 1996, do hereby certify that under requirements of P.A. 74, Michigan P.A. of 1970, the corner points mentioned in lines 1 and 2 above were in conformance with regulations and rules therefore as required in the current manual of survey instructions of the United States Department of the Interior, Bureau of Land Management or by a decree of a Court of Law and/or that the corner points mentioned in lines 3, 4 and 5 above were in conformance with the rules of the Michigan Board of Land Surveyors or by a Decree of a Court of Law; established, re-established, monumented, re-monumented, recovered, found as expressed below:

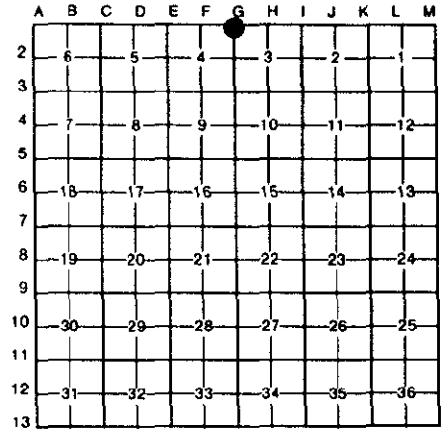

ALBION TWP.

NOTE: Not more than 4 corners, all in the same town and range, may be recorded on this certificate.

A. Description of original monument and accessories and/or subsequent restoration:

Original Government Survey, February, 1825, Red Oak 15" S 56-1/2° W 81 links; W. Oak 9" S 36° E 26 links. (Mullett) F.C. LYN
Roy Barry, June, 1939 & 1940: 1/2" pipe; 1.7' N.E. of 13" fence post; 19" cherry South 45.25'; 7" Black Oak S 15° W 24.0'.

B. Description of corner evidence found and/or method applied in restoring or reestablishing corner:

Found 1/2" x 18" iron rod 1.5' N.W. (not N.E.) of base of concrete fence post from above witnesses.

Three of above references were found.

SURVEY & REMONUMENTATION
MAR 21 1997
COMMISSION



C. Description of monument for corner and accessories established to perpetuate locating the position of the corner:

Replaced 1/2" x 18" iron rod with Berntsen monument and is accepted as a careful and faithful reestablishment of the position of the original corner.

1.5' N.N.W. of bottom face of 13" concrete post.
Nail & spotter S. side 36" Cherry South 46.1'.
Found nail & spotter E. side center 36" B. Oak S 10° W 23.50'.
Nail & spotter S. side 15" Sycamore S 60° E 109.98'.
N.W. corner foundation building #1315 S 70° E 167.88'.
About .8' West of N/S fence.
S.E. corner Section 33, Town 2 South, Range 4 West East 29.8'.

Signed by Frederick J. Cutcher Date November 7, 1996
Surveyor's Michigan License No. 24592