

MAR 30 1999

SECTION

APPROVED

Date 10-29-98 KRL

**CALHOUN COUNTY
REMONUMENTATION,**

**CALHOUN COUNTY REMONUMENTATION
LAND CORNER RECORDATION CERTIFICATE
Filing Requirement of Act 74, Mich. P.A. 1970**

STATE OF MICHIGAN
CALHOUN COUNTY
RECORDED

For corners in

29 OCT 1998 2:44:48 PM

CALHOUN Located In: Corner Code #

(County)
ALBION TWP.

- | | | | |
|---------------------------------------|---|----------|-----|
| 1. Public Land Survey | | T3S R4 W | G-5 |
| | | T R | |
| | | T R | |
| | | T R | |
| 2. Property Controlling
in Section | S | T R | |
| | S | T R | |
| 3. Miscellaneous
Property in Sec. | S | T R | |
| | S | T R | |

AINE D. NORLANDER
CLERK - REGISTER OF DEEDS
LIBER 2073 PAGE 296

Register of Deeds Stamp & File Number

4. Lot No. _____, Recorded Plat _____

5. Private Claims _____

I, Frederick J. Cutcher, in a field survey on October 15, 1998 do hereby state that under requirements of P.A. 74, Michigan P.A. of 1970, the corner points mentioned in lines 1 and 2 above were in conformance with regulations and rules therefore as required in the current manual of survey instructions of the United States Department of the Interior, Bureau of Land Management or by a decree of a Court of Law and/or that the corner points mentioned in lines 3, 4 and 5 above were in conformance with the rules of the Michigan Board of Land Surveyors or by a Decree of a Court of Law; established, re-established, monumented, recovered, found as expressed below:

	A	B	C	D	E	F	G	H	I	J	K	L	M
1													
2		6		5		4		3		2		1	
3													
4		7		8		9		10		11		12	
5							●						
6		18		17		16		15		14		13	
7													
8		19		20		21		22		23		24	
9													
10		30		29		28		27		26		25	
11													
12		31		32		33		34		35		36	
13													

NOTE: Not more than 2 corners, all in the same town and range, may be recorded on this certificate.

A. Description of original monument and accessories and/or subsequent restoration:

G.L.O. by Lucius Lyon, 12/12/1825: White Oak 11" N 46-1/2° W 48 lks; White Oak 18" S 39° E 31 lks.

Witness Card - Lyon, 1826: White Oak 11" N 46-1/2° W 48 lks; White Oak 18" S 39° E 31 lks.

Carr, 1991: Traverse notes indicate that this iron was found and tied in. No references were given.


B. Description of corner evidence found and/or method applied in restoring or reestablishing corner:

On 10/15/98 found 3/4" x 12" iron pipe in centerline of East-West road in line with fence and tree row North & South. Road has been cut approximately 5' here. No reference information was available.

C. Description of monument for corner and accessories established to perpetuate locating the position of the corner:

Replaced iron pipe with Harrison monument and is accepted as a careful and faithful reestablishment of the position of the original corner.

- Nail & spotter E. side R.R. tie fence post North 31.12'
- Nail & spotter N.E. side 14" Oak N 15° W 36.63'
- Nail & spotter N.E. side 10" Oak N 50° W 50.29'
- Nail & spotter W. side 12" Oak S 27° W 34.05'
- Nail & spotter W. side 8" Hickory S 8° W 41.69'

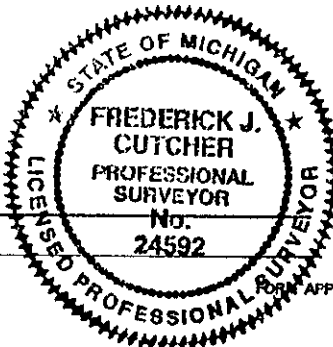

Signed by Frederick J. Cutcher
Surveyor's Michigan License No. 24592

Date 10/19/98