

MAR 30 1999

SECTION

APPROVED

Date 12-9-98 RRC
CALHOUN COUNTY
REMONUMENTATION

CALHOUN COUNTY REMONUMENTATION
LAND CORNER RECORDATION CERTIFICATE
Filing Requirement of Act 74, Mich. P.A. 1970

STATE OF MICHIGAN
CALHOUN COUNTY
RECORDED

For corners in

CALHOUN Located In: _____ Corner Code # _____
(County)
ALBION TWP.

15 DEC 1998 3:29:41 PM

ANNE B. NORLANDER
CLERK - REGISTER OF DEEDS

LIBER **2087** PAGE **912**

Register of Deeds Stamp & File Number

1. Public Land Survey		T <u>3</u> S R <u>4</u> W	<u>G-7</u>
		T _____ R _____	_____
		T _____ R _____	_____
		T _____ R _____	_____
2. Property Controlling in Section	S _____	T _____ R _____	_____
	S _____	T _____ R _____	_____
3. Miscellaneous Property in Sec.	S _____	T _____ R _____	_____
	S _____	T _____ R _____	_____

4. Lot No. _____, Recorded Plat _____
5. Private Claims _____

I, Frederick J. Cutcher, in a field survey on November 27, 1998 do hereby state that under requirements of P.A. 74, Michigan P.A. of 1970, the corner points mentioned in lines 1 and 2 above were in conformance with regulations and rules therefore as required in the current manual of survey instructions of the United States Department of the Interior, Bureau of Land Management or by a decree of a Court of Law and /or that the corner points mentioned in lines 3, 4 and 5 above were in conformance with the rules of the Michigan Board of Land Surveyors or by a Decree of a Court of Law; established, re-established, monumented, recovered, found as expressed below:

	A	B	C	D	E	F	G	H	I	J	K	L	M
1													
2		6		5			4		3		2		1
3													
4		7		8			9		10		11		12
5													
6		18		17			16		15		14		13
7													
8		19		20			21		22		23		24
9													
10		30		29			28		27		26		25
11													
12		31		32			33		34		35		36
13													

NOTE: Not more than 2 corners, all in the same town and range, may be recorded on this certificate.

A. Description of original monument and accessories and/or subsequent restoration:

G.L.O. by Lucius Lyon, 12/12/1825: White Oak 18" N 18-1/4° W 174 lks; Hickory 9" S 60° W 298 lks.

Field Notes - Carr, 1992: Set P.K. nail 33' south of R.R. tie post and 1' South of centerline for corner. Dug for corner & nothing found.

B. Description of corner evidence found and/or method applied in restoring or reestablishing corner:

On 11/27/98 found P.K. nail set by Carr & Assoc. 33' South of R.R. Track Post and 1' S. of centerline.


C. Description of monument for corner and accessories established to perpetuate locating the position of the corner:

Replaced P.K. nail with Berntsen monument in monument box and is accepted as the best available evidence of the position of the original corner.

Face of R.R. track post North 32.91'
Top center telephone stanchion N 13° W 29.22'
Set nail & spotter 12" Maple N 56° E 65.22'
Set nail & spotter N.E. side 8" Cedar S 50° E 38.60'
Set nail & spotter W. side 48" Oak S 35° E 47.5'

Signed by Frederick J. Cutcher
Surveyor's Michigan License No. 24592

Date 12/8/98

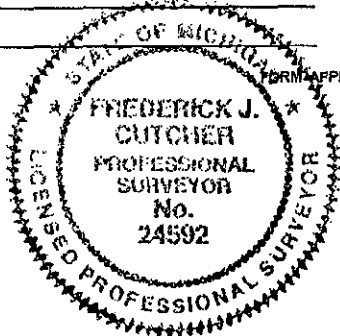

FORM APPROVED BY MICHIGAN STATE BOARD OF PROFESSIONAL SURVEYORS, JAN. 28, 197
REVISED MAY 14, 197
REVISED JAN., 198
REVISED OCT., 198