

MAR 30 1999

APPROVED

SECTION

Date 10-29-98 ARC

**CALHOUN COUNTY
REMONUMENTATION.**

**CALHOUN COUNTY REMONUMENTATION
LAND CORNER RECORDATION CERTIFICATE
Filing Requirement of Act 74, Mich. P.A. 1970**

STATE OF MICHIGAN
CALHOUN COUNTY
RECORDED

For corners in

29 OCT 1998 2:44:37 PM

CALHOUN _____ Located In: _____ Corner Code # _____

(County)
ALBION TWP.

1. Public Land Survey	T3S R4 W	H-5
	T _____ R _____	_____
	T _____ R _____	_____
	T _____ R _____	_____
2. Property Controlling in Section	S _____ T _____ R _____	_____
	S _____ T _____ R _____	_____
3. Miscellaneous Property in Sec.	S _____ T _____ R _____	_____
	S _____ T _____ R _____	_____

ANNE H. NORLANDER
CLERK - REGISTER OF DEEDS
LIBER **2073** PAGE **295**

Register of Deeds Stamp & File Number

4. Lot No. _____, Recorded Plat _____

5. Private Claims _____

	A	B	C	D	E	F	G	H	I	J	K	L	M
1													
2	6		5		4		3		2		1		
3													
4	7		8		9		10		11		12		
5								●					
6	16		17		16		15		14		13		
7													
8	19		20		21		22		23		24		
9													
10	30		29		28		27		26		25		
11													
12	31		32		33		34		35		36		
13													

I, Frederick J. Cutcher, in a field survey on October 14, 1998 do hereby state that under requirements of P.A. 74, Michigan P.A. of 1970, the corner points mentioned in lines 1 and 2 above were in conformance with regulations and rules therefore as required in the current manual of survey instructions of the United States Department of the Interior, Bureau of Land Management or by a decree of a Court of Law and for that the corner points mentioned in lines 3, 4 and 5 above were in conformance with the rules of the Michigan Board of Land Surveyors or by a Decree of a Court of Law; established, re-established, monumented, recovered, found as expressed below:

NOTE: Not more than 2 corners, all in the same town and range, may be recorded on this certificate.

A. Description of original monument and accessories and/or subsequent restoration:

G.L.O. by Lucius Lyon, 12/12/1825: Hickory 7" N 3° W 58 lks; Hickory 8" S 12° W 39 lks.

Witness Card - Lyon, 1826: Hickory 7" N 3° W 58 lks; Hickory 8" S 12° W 39 lks.

Witness Card - Walter, 6/27/67: 3/8" iron pipe; Fence corner N 52° E 35.38'; Fence post South 23.38'; T. post S 10° W 22.22'; 4" Maple N 47° W 42.06'; 8" Maple N 22° W 32.66'; just West of 10" Gasline (Marathon).

Witness Card - Walter, 6/28/67: Same as above.

Witness Card - Carr, 11/3/92: Found 3/4" pipe; Fence corner N 52° E 35.38'; Fence corner South 23.38'; U. pole S 10° W 22.22'; 16" Maple N 47° W 42.06'.

Survey 92-4957 - Carr 11/3/92: Same as above.

B. Description of corner evidence found and/or method applied in restoring or reestablishing corner:

From records of Walter and Carr found 3/4" x 8" iron pipe about 4" below gravel road surface.


C. Description of monument for corner and accessories established to perpetuate locating the position of the corner:

Replaced 3/4" x 8" iron pipe with Harrison Monument and is accepted as a careful and faithful reestablishment of the position of the original corner.

In centerline of E/W road, just West of pipeline.
Set nail & spotter West side fence post South 23.23'
Set nail & spotter E. side fence post N 52° E 35.90'
Center pipeline marker South 22.0'
Set nail & spotter E. side 18" Maple N 23° W 32.25'
Set nail & spotter N.E. side 8" Maple N 51° W 41.56'
Center pipeline marker North 22.92'

Signed by Frederick J. Cutcher

Surveyor's Michigan License No. 24592

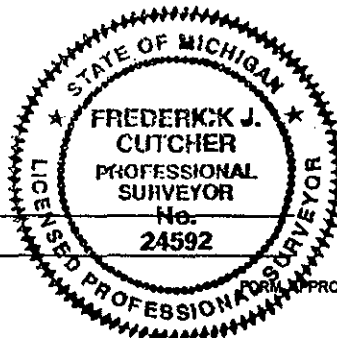

Date 10/19/98