

APPROVED

Date 11-18-98 *REL*

**CALHOUN COUNTY
REMONUMENTATION**

**CALHOUN COUNTY REMONUMENTATION
LAND CORNER RECORDATION CERTIFICATE
Filing Requirement of Act 74, Mich. P.A. 1970**

STATE OF MICHIGAN
CALHOUN COUNTY
RECORDED

For corners in

<u>CALHOUN</u>	Located in:	Corner Code #
(County)		
ALBION TOWNSHIP		
1. Public Land Survey	T <u>3S</u> R <u>4W</u>	<u>H-6</u>
	T <u> </u> R <u> </u>	<u> </u>
	T <u> </u> R <u> </u>	<u> </u>
	T <u> </u> R <u> </u>	<u> </u>
2. Property Controlling in Section	S <u> </u> T <u> </u> R <u> </u>	<u> </u>
	S <u> </u> T <u> </u> R <u> </u>	<u> </u>
3. Miscellaneous Property in Sec.	S <u> </u> T <u> </u> R <u> </u>	<u> </u>
	S <u> </u> T <u> </u> R <u> </u>	<u> </u>

19 NOV 1998 3:33:12 PM

ANNE B. NORLANDER
CLERK - REGISTER OF DEEDS

LIBER **2079** PAGE **921**

Register of Deeds Stamp & File Number

4. Lot No. _____, Recorded Plat _____
5. Private Claims _____

I, Michael A. Groat, in a field survey on October 23, 1998 do hereby state that under requirements of P.A. 74, Michigan P.A. of 1970, the corner points mentioned in lines 1 and 2 above were in conformance with regulations and rules therefore as required in the current manual of survey instructions of the United States Department of the Interior, Bureau of Land Management or by a decree of a Court of Law and for that the corner points mentioned in lines 3, 4 and 5 above were in conformance with the rules of the Michigan Board of Land Surveyors or by a Decree of a Court of Law; established, re-established, monumented, recovered, found as expressed below:

NOTE: Not more than 2 corners, all in the same town and range, may be recorded on this certificate.

	A	B	C	D	E	F	G	H	I	J	K	L	M
1													
2	6		5		4		3		2		1		
3													
4	7		8		9		10		11		12		
5													
6	18		17		16		15		14		13		
7													
8	19		20		21		22		23		24		
9													
10	30		29		28		27		26		25		
11													
12	31		32		33		34		35		36		
13													

A. Description of original monument and accessories and/or subsequent restoration:

NOT SET IN ORIGINAL SURVEY.
R.R. CARR SET 1/2" CAPPED IRON AT INTERSECTION OF 1/4 LINES.

**SURVEY &
REMONUMENTATION**

JUL 26 1999


B. Description of corner evidence found and/or method applied in restoring or reestablishing corner:

FOUND 1/2" CAPPED IRON SET BY CARR. ACCEPTED THIS POSITION AS THE CENTER OF SECTION.

SECTION

C. Description of monument for corner and accessories established to perpetuate locating the position of the corner:

SET BERNTSEN MONUMENT WITH CARSONITE MARKER BESIDE.
NAIL & TAG IN 20" OAK, SOUTH 10° EAST, 20.35'
NAIL & TAG IN 18" CHERRY, SOUTH 33° EAST, 23.95'
NAIL & TAG IN 16" CHERRY, NORTH, 72.82
NAIL & TAG IN 6" OAK, SOUTH 40° WEST, 68.0'

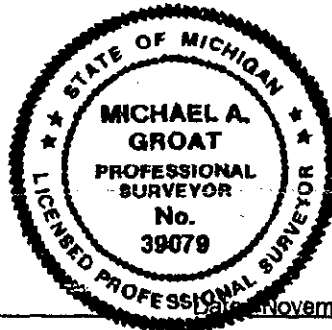

Signed by

Michael A. Groat

November 3, 1998

Surveyor's Michigan License No. 39079