

MAR 30 1999

APPROVED

SECTION

Date 12-9-98 REC  
CALHOUN COUNTY  
REMONUMENTATION

CALHOUN COUNTY REMONUMENTATION  
LAND CORNER RECORDATION CERTIFICATE  
Filing Requirement of Act 74, Mich. P.A. 1970

STATE OF MICHIGAN  
CALHOUN COUNTY  
RECORDED

For corners in

CALHOUN (County) ALBION TWP.	Located In:	Corner Code #
1. Public Land Survey	T3S R4 W	I-5
	T R	
	T R	
	T R	
2. Property Controlling in Section	S T R	
	S T R	
3. Miscellaneous Property in Sec.	S T R	
	S T R	

15 DEC 1998 3:28:15 PM

ANNE B. NORLANDER  
CLERK - REGISTER OF DEEDS

LIBER 2087 PAGE 911

Register of Deeds Stamp & File Number

4. Lot No. \_\_\_\_\_, Recorded Plat \_\_\_\_\_

5. Private Claims \_\_\_\_\_

I, Frederick J. Cutcher, in a field survey on December 1, 1998 do hereby state that under requirements of P.A. 74, Michigan P.A. of 1970, the corner points mentioned in lines 1 and 2 above were in conformance with regulations and rules therefore as required in the current manual of survey instructions of the United States Department of the Interior, Bureau of Land Management or by a decree of a Court of Law and/or that the corner points mentioned in lines 3, 4 and 5 above were in conformance with the rules of the Michigan Board of Land Surveyors or by a Decree of a Court of Law, established, re-established, monumented, recovered, found as expressed below:

	A	B	C	D	E	F	G	H	I	J	K	L	M
1													
2		6		5		4		3		2		1	
3													
4		7		8		9		10		11		12	
5									●				
6		18		17		16		15		14		13	
7													
8		19		20		21		22		23		24	
9													
10		30		29		28		27		26		25	
11													
12		31		32		33		34		35		36	
13													

NOTE: Not more than 2 corners, all in the same town and range, may be recorded on this certificate.

A. Description of original monument and accessories and/or subsequent restoration:

G.L.O. by Lucius Lyon, 12/12/1825: B. Oak 6" N 21-1/2°E 17 lks; B. Oak 7" S 62°E 30 lks.

Witness Card - Max W. Walter, 6/27/87: 3/4" iron rod in intersection of M-99 & D Drive South; T. pole N 50°E 38.12'; 32" Oak N 78°E 101.44'; 27" Stump S 19° E 104.04'; USGS BM on Hdwl S 64° W 43.63'; P. Pole N 57° W 61.00'.

Field Notes - Carr, 11/3/92: Found 1" iron in monument box at intersection of N/S & E/W roads; Util. pole N. 56°W 60.90'; 40" Oak N 80° E 101.4'; Fence corner N 58° E 37.7'.


B. Description of corner evidence found and/or method applied in restoring or reestablishing corner:

On 12/1/98 found 1" iron bolt in monument box in centerline intersection of Hwy. M-99 and D Drive South. Carr & Assoc. references remain.

C. Description of monument for corner and accessories established to perpetuate locating the position of the corner:

Left bolt and monument box as found and is accepted as the best available evidence of the position of the original corner.

- Found nail & spotter Util. pole N 60° W 60.86'
- Set nail & spotter 48" Oak N 80° E 101.56'
- Top center telephone stanchion S 20° W 98.70'
- Found nail 10" Hickory S 30° E 75.55'
- Top center plastic riser to gas line N 55°E 54.47'

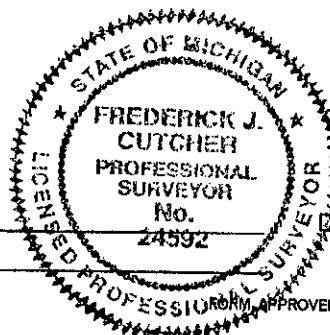

Signed by Frederick J. Cutcher  
Surveyor's Michigan License No. 24592

Date 12/8/98