

MAR 3 1999

SECTION

STATE OF MICHIGAN
CALHOUN COUNTY
RECORDED

15 DEC 1998 3:27:39 PM

APPROVED

Date 12-9-98 Rec
**CALHOUN COUNTY
REMONUMENTATION.**

**CALHOUN COUNTY REMONUMENTATION
LAND CORNER RECORDATION CERTIFICATE**
Filing Requirement of Act 74, Mich. P.A. 1970

ANNE B. NORLANDER
CLERK - REGISTER OF DEEDS

LIBER **2087** PAGE **908**

Register of Deeds Stamp & File Number

For corners in

CALHOUN	Located In:	Corner Code #
(County)		
ALBION TWP.		
1. Public Land Survey	T3S R4 W	K-7
	T R	
	T R	
	T R	
2. Property Controlling in Section	S T R	
	S T R	
3. Miscellaneous Property in Sec.	S T R	
	S T R	

4. Lot No. _____, Recorded Plat _____

5. Private Claims _____

I, Frederick J. Cutcher, in a field survey on November 27, 19 98 do hereby state that under requirements of P.A. 74, Michigan P.A. of 1970, the corner points mentioned in lines 1 and 2 above were in conformance with regulations and rules therefore as required in the current manual of survey instructions of the United States Department of the Interior, Bureau of Land Management or by a decree of a Court of Law and /or that the corner points mentioned in lines 3, 4 and 5 above were in conformance with the rules of the Michigan Board of Land Surveyors or by a Decree of a Court of Law, established, re-established, monumented, recovered, found as expressed below:

NOTE: Not more than 2 corners, all in the same town and range, may be recorded on this certificate.

A	B	C	D	E	F	G	H	I	J	K	L	M
1												
2	6		5		4		3		2		1	
3												
4	7		8		9		10		11		12	
5												
6	13		17		16		15		14		13	
7												
8	19		20		21		22		23		24	
9												
10	30		29		28		27		26		25	
11												
12	31		32		33		34		35		36	
13												

A. Description of original monument and accessories and/or subsequent restoration:

G.L.O. by Lucius Lyon, 12/12/1825: Burr Oak 8" S 36° E 13 lks.; Burr Oak 6" N 62-3/4° W 170 lks.

Witness Card - Carr, 7/91: Found 1/2" iron in centerline of road (no previous witnesses available); P.K. in 40" Oak N 75° W 81.35'; P.K. in 40" Oak S 70° E 92.74'; P.K. in Util. pole S 40° W 90.09'; P.K. in 18" Hickory S 50° E 54.66'.

Witness Card - Carr, 11/3/92: Found 1/2" iron in centerline intersection ; 18" Hickory S 45° E 54.70'; 30" Oak N 72° W 81.40'; Twin 16" Hickory S 74° W 84.50'; 40" Oak N 18° E 119.65'.

B. Description of corner evidence found and/or method applied in restoring or reestablishing corner:

On 11/27/98 found 1/2" x 18" iron in centerline intersections of roads. All of Carr's references remain.


C. Description of monument for corner and accessories established to perpetuate locating the position of the corner:

Replaced 1/2" x 18" iron with Berntsen monument in monument box and is accepted as the best available evidence of the position of the original corner.

Found nail & ribbon 18" Hickory S 45° E 54.70'
Found nail & ribbon 40" Oak N 18° E 119.65'
Found nail & spotter 30" Oak N 72° W 81.40'
Found nail & spotter 18" Elm S 42° W 60.86'

Signed by Frederick J. Cutcher
Surveyor's Michigan License No. 24592

Date 12/8/98

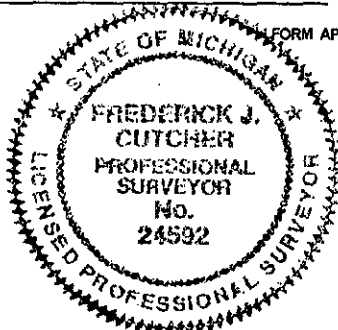

FORM APPROVED BY MICHIGAN STATE BOARD OF PROFESSIONAL SURVEYORS, JAN. 28, 197
REVISED MAY 14, 197
REVISED JAN., 198
REVISED OCT., 199