

MAR 30 1999

SECTION 1

STATE OF MICHIGAN
CALHOUN COUNTY
RECORDED

APPROVED

Date 10-29-98 *RRL*

**CALHOUN COUNTY
REMONUMENTATION.**

**CALHOUN COUNTY REMONUMENTATION
LAND CORNER RECORDATION CERTIFICATE
Filing Requirement of Act 74, Mich. P.A. 1970**

29 OCT 1998 2:43:15 PM

ANNE B. NORLANDER
CLERK - REGISTER OF DEEDS

LIBER **2073** PAGE **288**

For corners in

CALHOUN _____ Located In: _____ Corner Code # _____
(County)
ALBION TWP.

1. Public Land Survey		T3S R4 W	K-8
		T_____ R_____	_____
		T_____ R_____	_____
		T_____ R_____	_____
2. Property Controlling in Section	S_____	T_____ R_____	_____
	S_____	T_____ R_____	_____
3. Miscellaneous Property in Sec.	S_____	T_____ R_____	_____
	S_____	T_____ R_____	_____

4. Lot No. _____, Recorded Plat _____

5. Private Claims _____

I, Frederick J. Cutcher, in a field survey on October 8, 1998 do hereby state that under requirements of P.A. 74, Michigan P.A. of 1970, the corner points mentioned in lines 1 and 2 above were in conformance with regulations and rules therefore as required in the current manual of survey instructions of the United States Department of the Interior, Bureau of Land Management or by a decree of a Court of Law and /or that the corner points mentioned in lines 3, 4 and 5 above were in conformance with the rules of the Michigan Board of Land Surveyors or by a Decree of a Court of Law; established, re-established, monumented, recovered, found as expressed below:

NOTE: Not more than 2 corners, all in the same town and range, may be recorded on this certificate.

A. Description of original monument and accessories and/or subsequent restoration:

G.L.O. by Lucius Lyon, 12/12/1825: Hickory 10" N 26 1/2° E 23 lks; Burr Oak 6" S 31° W 27 lks.

Witness Card - Lyon, 1826: Hickory 10" N. 26 1/2° E 23 lks; Burr Oak 6" S 31° W 27 lks.

Witness Card - Carr, 11/3/92: Found 16" stone w/chisled "x" on top. Set 1/2" capped iron & laid stone beside; 30" Oak N 86° W 28.98'; 24" Oak N 76° E 25.80'; 24" cherry S 35° W 54.51'; 40" Maple S 10° E 124.65'.

Survey 92-4957B, Carr & Assoc. November 5, 1992: 1/2" iron at centerline N-S road; 10" Oak N 86°W 28.98'; 24" Oak N 76° E 25.80'; 24" Cherry S 35° W 54.51'; 40" Maple S 10° E 124.65'.


B. Description of corner evidence found and/or method applied in restoring or reestablishing corner:

On 10/8/98 found 1/2" x 18" iron w/cap #20704 w/16" oblong stone lying on N. side from Carr's references of 11/3/92 (all references remain).

C. Description of monument for corner and accessories established to perpetuate locating the position of the corner:

Replaced capped iron with Berntsen monument in a monument box in centerline of N-S road; in line with fence/tree row E-W and is accepted as a careful and faithful reestablishment of the position of the original corner.

Set nail & spotter S. side 24" Ash N 73° E 25.74'
Set nail & spotter S. side 30" Oak N 84° W 28.95'
Set nail & spotter N. side 24" Oak S 68° W 32.90'
S.E. cor. house foundation N 40° W 165.5'
40" Maple (center) S 10° E 124.65'
24" Cherry (center) S 35° W 54.5'

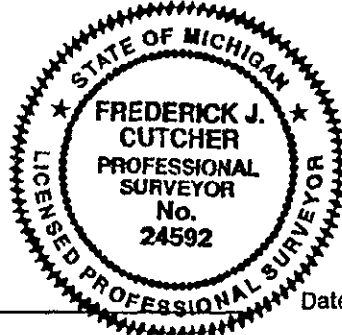

Signed by Frederick J. Cutcher
Surveyor's Michigan License No. 24592

Date 10/19/98

1	A	B	C	D	E	F	G	H	I	J	K	L	M
2		6		5		4		3		2		1	
3													
4		7		8		9		10		11		12	
5													
6		18		17		16		15		14		13	
7													
8		19		20		21		22		23		24	
9													
10		30		29		28		27		26		25	
11													
12		31		32		33		34		35		36	
13													

Register of Deeds Stamp & File Number