

APPROVED

Date 10-29-98 KRC

**CALHOUN COUNTY
REMONUMENTATION.**

**CALHOUN COUNTY REMONUMENTATION
LAND CORNER RECORDATION CERTIFICATE
Filing Requirement of Act 74, Mich. P.A. 1970**

STATE OF MICHIGAN
CALHOUN COUNTY
RECORDED

For corners in

CALHOUN

(County)
ALBION TWP.

Located In:

Corner Code #

1. Public Land Survey

T3S R4 W

K-9

2. Property Controlling
in Section

3. Miscellaneous
Property in Sec.

T
T
T
S
S
S
S
T
R
R
R
R
R
R
R
R

29 OCT 1998 2:43:27 PM

ANNE D. NORLANDER
CLERK - REGISTER OF DEEDS
LIBER **2073** PAGE **289**

Register of Deeds Stamp & File Number

4. Lot No. _____, Recorded Plat _____

5. Private Claims _____

1	A	B	C	D	E	F	G	H	I	J	K	L	P
2	6		5		4		3		2		1		
3													
4	7		8		9		10		11		12		
5													
6	18		17		16		15		14		13		
7													
8	19		20		21		22		23		24		
9													
10	30		29		28		27		26		25		
11													
12	31		32		33		34		35		36		
13													

I, Frederick J. Cutcher, in a field survey on October 8, 1998 do hereby state that under requirements of P.A. 74, Michigan P.A. of 1970, the corner points mentioned in lines 1 and 2 above were in conformance with regulations and rules therefore as required in the current manual of survey instructions of the United States Department of the Interior, Bureau of Land Management or by a decree of a Court of Law and for that the corner points mentioned in lines 3, 4 and 5 above were in conformance with the rules of the Michigan Board of Land Surveyors or by a Decree of a Court of Law; established, re-established, monumented, recovered, found as expressed below:

NOTE: Not more than 2 corners, all in the same town and range, may be recorded on this certificate.

A. Description of original monument and accessories and/or subsequent restoration:

G.L.O. by Lucius Lyon, 12/12/1825: Burr Oak 8" S 85° W 37 lks; Burr Oak 8" N 3 1/2° W 85 lks.

Witness Card - Lyon, 1826: Burr Oak 8" S 85° W 37 lks; Burr Oak 8" N 3 1/2° W 85 lks.

Witness Card - Gertz, 8/31/83: Found large staple w/ribbon. Set 1/2" iron in place of staple; 36" Maple N 45° E 49.90'; 36" Maple N 45° W 60.34'; Top cen. tele. Stanchion S 45° E 50.7'; Bottom of wood fence cor. S 45° W 51.4'; in approx. centerlines of gravel roads.

Witness Card - Carr, 11/3/92: Found 1/2" iron 8" deep: 38" Maple N 30° E 49.95'; 40" Maple N 42° W 60.39'; 48" Maple S 2° E 162.05'; 30" Oak N 77° E 145.90'.


B. Description of corner evidence found and/or method applied in restoring or reestablishing corner:

On 10/8/98 found 1/2" x 24" iron 8" below road surface from Carr's references of 11/3/92 (all references remain).

C. Description of monument for corner and accessories established to perpetuate locating the position of the corner:

Replaced iron with Berntsen monument in a monument box in centerline intersection of roads and is accepted as a careful and faithful reestablishment of the position of the original corner.

- Found nail & spotter 38" Maple N 30° E 49.95'
- Found nail & spotter 40" Maple N 42° W 60.39'
- Found nail & spotter 48" Maple S 2° E 162.05'
- Found nail & spotter 30" Oak N 77° E 145.90'
- S.E. cor. school foundation N 50° W 156.60'

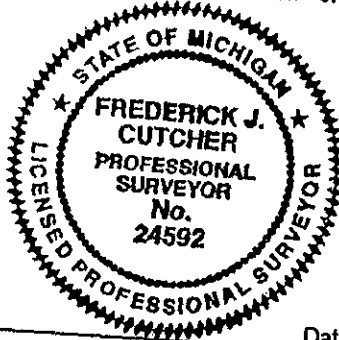

Signed by Frederick J. Cutcher
Surveyor's Michigan License No. 24592

Date 10/19/98